

15-169-00407-00-00

RECEIVED
STATE CORPORATION COMMISSION

JUN 28 1971 Form CP-4


CONSERVATION DIVISION
Wichita, Kansas

WELL PLUGGING RECORD

STATE OF KANSAS
STATE CORPORATION COMMISSION

Give All Information Completely
Make Required Affidavit
Mail or Deliver Report to:
Conservation Division
State Corporation Commission
212 No. Market
Wichita, Kansas 67202

NORTH

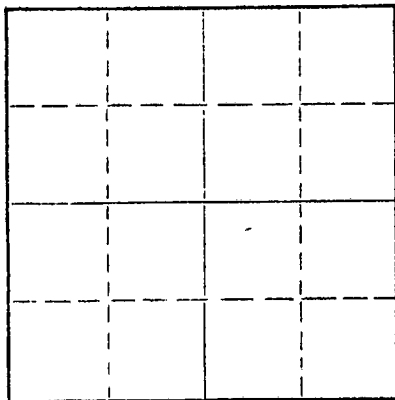

Locate well correctly on above
Section Plat

Saline County, Sec. 9 Twp. 14 Rge. 2 (E) (W) x

Location as "NE/CNW/SW" or footage from lines SW SW

Lease Owner Okmar Oil Co.

Lease Name Anderson Well No. #1

Office Address 1130 Vickers KSB&T Bldg. Wichita, Kansas

Character of Well (completed as Oil, Gas or Dry Hole)

Date well completed 19

Application for plugging filed 5-27-71 19

Application for plugging approved 19

Plugging commenced 6-21-71 19

Plugging completed 6-24-71 19

Reason for abandonment of well or producing formation

If a producing well is abandoned, date of last production 19

Was permission obtained from the Conservation Division or its agents before plugging was commenced?

Name of Conservation Agent who supervised plugging of this well Gilbert Toman

Producing formation Depth to top Bottom Total Depth of Well 3168 1/2 feet

Show depth and thickness of all water, oil and gas formations.

OIL, GAS OR WATER RECORDS

CASING RECORD

FORMATION	CONTENT	FROM	TO	SIZE	PUT IN	PULLED OUT
				4 1/2"	3168'	2500.13'
				8 5/8"	215'	

Describe in detail the manner in which the well was plugged, indicating where the mud fluid was placed and the method or methods used in introducing it into the hole. If cement or other plugs were used, state the character of same and depth placed, from feet to feet for each plug set.

Made bottom hole plug back with sand to 3150'. Mixed and ran 4 sacks cement thru dump bailer.
Mudded hole to 230', set 10' rock bridge. Mixed and ran 25 sacks cement thru dump bailer. Mudded hole to 40', set 10' rock bridge. Mixed and dumped 10 sacks cement to base of cellar.

(If additional description is necessary, use BACK of this sheet)

Name of Plugging Contractor Southwest Casing Pulling Co.

Address Box 364 Great Bend, Kansas


STATE OF Kansas, COUNTY OF Barton, ss.

Southwest Casing Pulling Co. (employee of owner) or (owner or operator) of the above-described well, being first duly sworn on oath, says: That I have knowledge of the facts, statements, and matters herein contained and the log of the above-described well as filed and that the same are true and correct. So help me God.

(Signature) W. C. Spencer Sec.

Box 364, Great Bend, Kansas (Address)

SUBSCRIBED AND SWORN to before me this 25 day of June, 19 71

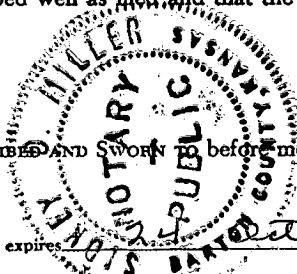

Sidney D. Miller Notary Public.

My commission expires October 1972

WELL LOG - D. ANDERSON NO. 1

15-169-00407-00-00

Donald T. Ingling et al, Lease Owner

Section 9-14-2W

Donald T. Ingling, Contractor

Location: SW SW

Commenced: 1-13-64

County: Saline

Completed: 1-22-64

Production:

Total Depth: 3168 1/2 (rotary)

Elevation: 1232 RB

Casing: 8 5/8" 215' (110 sacks cement)
4 1/2" 3168' (50 sacks cement)

Figures below indicate bottom formation

- 50 shale and sand streaks
- 125 lime and shale
- 210 lime
- 530 lime and shale streaks
- 760 lime and shale streaks
- 850 lime and shale
- 1100 shale and shells
- 1425 shale
- 1720 shale and lime streaks
- 1840 lime and shale
- 1890 shale
- 2030 lime
- 2250 lime and shale
- 2380 lime and shells
- 2460 lime
- 2600 lime and shale streaks
- 2617 lime and shale
- 2660 lime
- 2750 lime - cherty
- 2790 lime
- 2823 lime
- 2865 shale and lime
- 2970 shale
- 3065 lime
- 3083 lime
- 3145 shale
- 3167 1/2 shale
- 3168 1/2 dolomite
- 3168 1/2 Total Depth

RECEIVED
STATE CORPORATION COMMISSION
MAY 28 1971
CONSERVATION DIVISION
Wichita, Kansas

I certify this is a true and correct copy of the above mentioned well.

STATE OF KANSAS)
SEDGWICK COUNTY) SS.

D. T. Ingling

Subscribed and sworn to before me, a Notary public, in said county and state.

M. E. Black
Notary Public

My commission expires: Feb. 27, 1964