

CARD MUST BE TYPED

State of Kansas

CARD MUST BE SIGNED

NOTICE OF INTENTION TO DRILL

(see rules on reverse side)

OWWO

API Number 15— 171-20,080-00-01

Starting Date 6/23/87
month day year

— East
C SE NW Sec. 25 Twp. 19 S, Rg. 34 West
3300' Ft. from South Line of Section
3300' Ft. from East Line of Section

OPERATOR: License # 5210
Name Lebsack Oil Production, Inc.
Address P.O. Box 489
City/State/Zip Hays, Kansas 67601
Contact Person Wayne Lebsack
Phone 316-938-2396

(Note: Locate well on Section Plat on reverse side)
Nearest lease or unit boundary line 1980' feet

CONTRACTOR: License # 5422
Name Abercrombie Drilling
City/State 801 Union Center, Wichita, Ks.

County Scott
Lease Name Fairleigh Well # 1 (OWWO)

Well Drilled For: Well Class: Type Equipment:
 Oil SWD Infield Mud Rotary
 ~~Gas Inj Pool-Ext. Air Rotary~~
 OWWO Expl Wildcat Cable

Ground surface elevation 3011 GL feet MSL
Domestic well within 330 feet: yes no
Municipal well within one mile: yes no
Depth to bottom of fresh water 200
Depth to bottom of usable water ~~150~~ 1300

If OWWO: old well info as follows:
Operator Maurice L. Brown & Wayne Woosley
Well Name Fairleigh #1
Comp Date 11/10/75 Old Total Depth 5067'

Surface pipe by Alternate: 1 2
Surface pipe ~~planned to be set~~ 356' w/300 sx.
Conductor pipe required
Projected Total Depth 5067 feet
Formation Miss.-Morrow-

I certify that well will comply with K.S.A. 55-101, et seq., plus eventually plugging hole to KCC specifications.
Date 6/17/87 Signature of Operator or Agent Rex Curtis Title Operator


For KCC Use:
Conductor Pipe Required _____ feet; Minimum Surface Pipe Required 220 feet per Alt. 2
This Authorization Expires 12-19-87 Approved By Pat 6-19-87

Must be filed with the K.C.C. five (5) days prior to commencing well
This card void if drilling not started within six (6) months of date received by K.C.C.

Important procedures to follow:

1. Notify District office before setting surface casing.
2. Set surface casing by circulating cement to the top.
3. File completion forms ACO-1 with K.C.C. within 90 days of well completion, following instructions on ACO-1, side 1, and including copies of wireline logs.
4. Notify District office 48 hours prior to old well workover or re-entry.
5. Prior to filing Intent, prepare a proposed plugging plan in case well is D & A, then obtain approval of plan when calling district office prior to setting surface pipe.
6. ~~Submit plugging report (CP-4) to K.C.C. after plugging is completed.~~
7. Obtain an approved injection docket number before disposing of salt water.
8. Notify K.C.C. within 10 days when injection commences or terminates.
9. If an alternate 2 completion, cement in the production pipe from below any usable water to surface within 120 days of spud date.

A Regular Section of Land 1 Mile = 5,280 Ft.

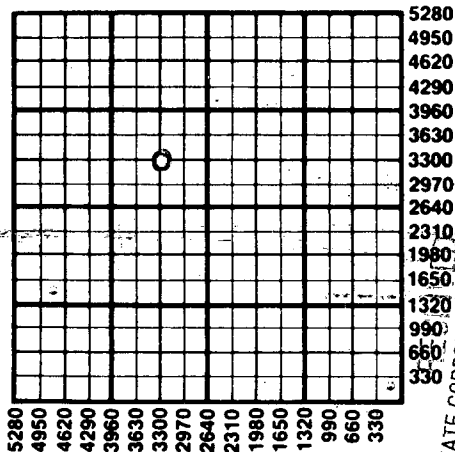

STATE CORPORATION COMMISSION

JUN 19 1987

CONSERVATION DIVISION
Wichita, Kansas

State Corporation Commission of Kansas
Conservation Division
200 Colorado Derby Building
Wichita, Kansas 67202
(316) 263-3238