

CARD MUST BE TYPED

State of Kansas  
**NOTICE OF INTENTION TO DRILL**  
(see rules on reverse side)

CARD MUST BE SIGNED

Starting Date: 7-1-88 7 1 1984  
month day year

OPERATOR: License # 5120  
Name Range Oil Company, Inc.  
Address 240 Page Court  
City/State/Zip Wichita, Kansas 67202  
Contact Person John Washburn  
Phone (316) 265-6231

CONTRACTOR: License # 5124  
Name Range Drilling Co., Inc.  
City/State Wichita, Kansas 67202

Well Drilled For: Well Class: Type Equipment:  
 Oil  Swd  Infield  Mud Rotary  
 Gas  Inj  Pool Ext.  Air Rotary  
 OWWO  Expl  Wildcat  Cable

If OWWO: old well info as follows:

Operator .....  
Well Name .....  
Comp Date ..... Old Total Depth .....  
Projected Total Depth 2750 feet  
Projected Formation at TD Mississippian  
Expected Producing Formations Mississippian

I certify that we will comply with K.S.A. 55-101, et seq., plus eventually plugging hole to K.C.C. specifications.

Date 6-15-84 Signature of Operator or Agent

John M. Washburn Title Exploration Manager

API Number 15- 169-20,252-00-00

N/2 SE NW Sec 24 Twp 15 S, Rge 2 West  
(location) 3630 Ft North from Southeast Corner of Section  
3300 Ft West from Southeast Corner of Section  
(Note: Locate well on Section Plat on reverse side)

Nearest lease or unit boundary line 660 feet.  
County Saline

Lease Name Johnson "B" Well# 1

Domestic well within 330 feet:  yes  no  
Municipal well within one mile:  yes  no


Depth to Bottom of fresh water 90 feet  
Lowest usable water formation Alluvial deposits Wellington  
Depth to Bottom of usable water 200 feet  
Surface pipe by Alternate: 1  2   
Surface pipe to be set 200 feet  
Conductor pipe if any required --- feet  
Ground surface elevation 1284 feet MSL  
This Authorization Expires 6-12-1984  
Approved By 6-15-84

MHC/KOME 6-15-84

Must be filed with the K.C.C. five (5) days prior to commencing well  
This card void if drilling not started within six (6) months of date received by K.C.C.

*Rec.*  
6-15-1984

**A Regular Section of Land**  
1 Mile = 5,280 Ft.

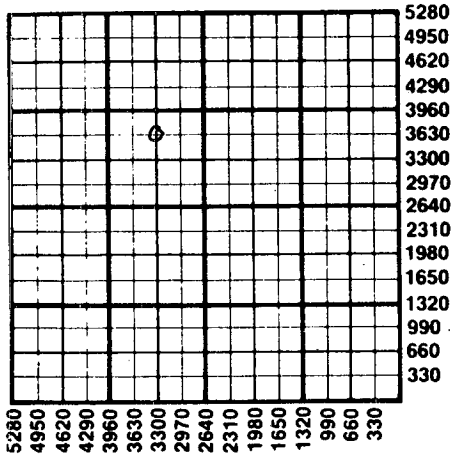

**Important procedures to follow :**

1. Notify District office before setting surface casing.
2. Set surface casing by circulating cement to the top.
3. File completion forms ACO-1 with K.C.C. within 90 days of well completion, following instructions on ACO-1, side 1, and including copies of wireline logs.
4. Notify District office 48 hours prior to old well workover or re-entry.
5. Prior to plugging, prepare a plugging plan, then obtain agreement from the appropriate district office for an approved plugging plan.
6. Submit plugging report (CP-4) to K.C.C. after plugging is completed.
7. Obtain an approved injection docket number before disposing of salt water.
8. Notify K.C.C. within 10 days when injection commences or terminates.
9. If an alternate 2 completion, cement in the production pipe from below any usable water to surface within 120 days of spud date.

**State Corporation Commission of Kansas**  
**Conservation Division**  
**200 Colorado Derby Building**  
**Wichita, Kansas 67202**  
**(316) 263-3238**