


Give All Information Completely
Make Required Affidavit
Mail or Deliver Report to:
Conservation Division
State Corporation Commission
211 No. Broadway
Wichita, Kansas

WELL PLUGGING RECORD

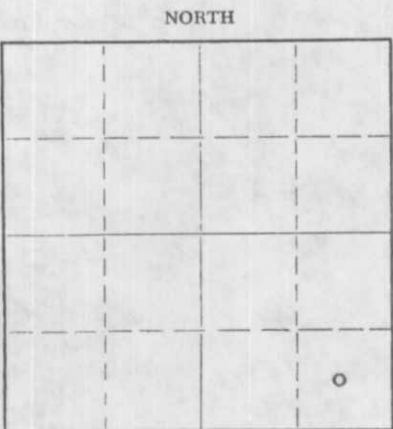

Locate well correctly on above Section Plat

Scott County. Sec. 35 Twp. 17S Rge. 32W (E) (W)
Location as "NE/CNW/SW" or footage from lines C SE SE
Lease Owner MORRISON Producing Company
Lease Name Huck-Callen Well No. 1
Office Address Box 712, Eldorado, Kansas
Character of Well (completed as Oil, Gas or Dry Hole) Dry Hole
Date well completed August 2 19 63
Application for plugging filed August 2 19 63
Application for plugging approved August 2 19 63
Plugging commenced August 2 19 63
Plugging completed August 2 19 63
Reason for abandonment of well or producing formation Dry Hole

If a producing well is abandoned, date of last production _____ 19____
Was permission obtained from the Conservation Division or its agents before plugging was commenced? Yes

Name of Conservation Agent who supervised plugging of this well W. L. Nichols, Moreland, Kansas
Producing formation _____ Depth to top _____ Bottom _____ Total Depth of Well _____ Feet
Show depth and thickness of all water, oil and gas formations.

OIL, GAS OR WATER RECORDS

CASING RECORD

FORMATION	CONTENT	FROM	TO	SIZE	PUT IN	PULLED OUT
		0	327'	8 5/8"	327'	None

Describe in detail the manner in which the well was plugged, indicating where the mud fluid was placed and the method or methods used in introducing it into the hole. If cement or other plugs were used, state the character of same and depth placed, from _____ feet to _____ feet for each plug set.

Set Plug @ 600' w/20 sacks cement
Plug @ 300' w/20 sacks cement
Plug @ 40' w/10 sacks cement

RECEIVED
STATE CORPORATION COMMISSION
AUG 14 1963
08-14-1963
CONSERVATION DIVISION
Wichita, Kansas

(If additional description is necessary, use BACK of this sheet)
Name of Plugging Contractor Hellar Drilling Company, Inc.
Address 1014 Union Center, Wichita, Kansas

STATE OF Kansas COUNTY OF Sedgwick, ss.
D.L.Hellar, Pres. of Hellar Drilg.Co.Inc. (employee of owner) or (owner or operator) of the above-described well, being first duly sworn on oath, says: That I have knowledge of the facts, statements, and matters herein contained and the log of the above-described well as filed and that the same are true and correct. So help me God.

(Signature) D. L. Hellar D. L. Hellar, President
1014 Union Center, Wichita, Kansas

SUBSCRIBED AND SWORN TO before me this 8th day of August, 19 63

My commission expires March 25, 1964

Catherine Darcey
Catherine Darcey -- Notary Public.

DRILLER'S LOG

COMPANY: MORRISON PRODUCING COMPANY
 CONTRACTOR: Hellar Drilling Company, Inc.
 LEASE: #1 Huck-Callen
 LOCATION: C SE SE Sec. 35-17S-32W, Scott County, Kansas
 COMMENCED: July 15, 1963
 COMPLETED: August 1, 1963
 CASING: Set 8 5/8" surface casing @ 327'/275 sacks cement

0-280	Sand, clay, shale
280-410	Shale
410-1560	Shale, sand, shells
1560-1777	Shale
1777-1815	Anhydrite (Blaine)
1815-1856	Red Bed
1856-2257	Shale, sand & Red Bed
2257-2320	Cimmarron (Anhydrite)
2320-2376	Shale
2376-2615	Shale & Shells
2615-2800	Shale & Lime
2800-3014	Ft. Riley Section
3014-3205	Lime & Shale
3205-3327	Lime
3327-3378	Lime w/shale streaks
3378-3442	Lime
3442-3522	Lime w/shale
3522-3577	Waubaunsee
3577-3910	Lime & Shale
3910-3998	Lime
3998-4000	K. C. lime
4000-4030	Lime
4030-4052	K. C. lime
4052-4086	L. K.C.
4086-4126	Lime
4126-4154	K. C. lime
4154-4212	Lans. K. C.
4212-4262	Lime
4262-4300	K. C. lime
4300-4362	Lime & shale
4362-4401	Lime
4401-4446	Lime w/shale
4446-4471	Marmaton lime
4471-4513	Lime
4513-4553	Ft. Scott
4553-4579	Lime & shale streaks
4579-4616	Lime (Miss. 4590)
4616-4621	Miss. Lime
4621-4760	Mississippian
4760-4790	Spergen
4790	Rotary Total Depth
	D & A

RECEIVED
STATE CORPORATION COMMISSION

AUG 14 1963
08-14-1963
CONSERVATION DIVISION
Wichita, Kansas

STATE OF KANSAS)
) ss
 COUNTY OF SEDGWICK)

I, D. L. Hellar, do hereby certify that the above and foregoing is a true and correct copy of the log of the #1 Huck-Callen, located in C SE SE Sec. 35-17S-32W, Scott County, Kansas, as reflected by the files of the Hellar Drilling Company, Inc.

HELLAR DRILLING COMPANY, INC.

By D. L. Hellar
 President - D. L. Hellar

Subscribed and sworn to before me, a Notary Public, in and for Sedgwick County, Kansas, this 8th day of August, 1963.

My Commission Expires:
 March 25, 1964.

Catherine Darcey
 Notary Public - Catherine Darcey







