


Give All Information Completely
Make Required Affidavit
Mail or Deliver Report to:
Conservation Division
State Corporation Commission
211 No. Broadway
Wichita, Kansas

WELL PLUGGING RECORD

NORTH

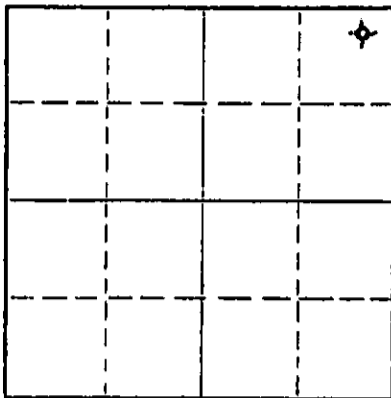

Locate well correctly on above Section Plat

Scott County, Sec. 35 Twp. 17S Rge. 32W ~~25X~~ (W)

Location as "NE/CNWxSWx" or footage from lines 200' SW of C NE NE NE

Lease Owner Cimarron Exploration, Inc.

Lease Name Crowell

Well No. 1

Office Address Box 1142, Liberal, Kansas

Character of Well (completed as Oil, Gas or Dry Hole) Dry Hole

Date well completed November 15 19 65

Application for plugging filed November 15 19 65

Application for plugging approved November 15 19 65

Plugging commenced November 15 19 65

Plugging completed November 15 19 65

Reason for abandonment of well or producing formation

If a producing well is abandoned, date of last production 19

Was permission obtained from the Conservation Division or its agents before plugging was commenced? Yes

Name of Conservation Agent who supervised plugging of this well W. L. Nichols

Producing formation Depth to top Bottom Total Depth of Well 4403 Feet

Show depth and thickness of all water, oil and gas formations.

OIL, GAS OR WATER RECORDS

CASING RECORD

FORMATION	CONTENT	FROM	TO	SIZE	PUT IN	PULLED OUT
				8 5/8"	242	None

Describe in detail the manner in which the well was plugged, indicating where the mud fluid was placed and the method or methods used in introducing it into the hole. If cement or other plugs were used, state the character of same and depth placed, from feet to feet for each plug set.

~~Set~~ Set Plug @ 660' to 591' with 20 Sacks cement
Set Plug @ 245' to 189' with 20 Sacks cement
Set Plug @ 40' to Surface with 10 Sacks cement

DEC 27 1965
12-27-1965
RECEIVED
WICHITA, KANSAS

(If additional description is necessary, use BACK of this sheet)
Name of Plugging Contractor Earl F. Wakefield
Address 515 Union Center Building, Wichita, Kansas

STATE OF Kansas COUNTY OF Seward ss.
W.R. Atkinson

W.R. Atkinson (owner or operator) of the above-described well, being first duly sworn on oath, says: That I have knowledge of the facts, statements, and matters herein contained and the log of the above-described well as filed and that the same are true and correct. So help me God

(Signature) W.R. Atkinson
Box 1142 Liberal, Kansas 67901 (Address)

SUBSCRIBED AND SWORN TO before me this 24th day of December 19 65

My Commission Expires March 4, 1966
My commission expires
Notary Public.

15-171-30058-00-00

LEASE: CROWELL #1
OWNER: CIMARRON EXPLORATION, INC.
CONT: EARL F. WAKEFIELD
COM: 11-3-65
COMP: 11-15-65

LOCATION: NE NE
SECTION 35-17S-32W
SCOTT COUNTY, KANSAS
CASING: 8 5/8" SET @ 242'
T.D. @ 4403' D & A

Surface Soil	45
Sand	190
Clay	225
Blue Shale	247
Shells & Clay	1450
Shale	1760
Shale, Shells, Salt	2250
Shale	2440
Shale & Shells	2795
Shale W/Lime	2922
Lime & Shale	3155
Shale W/Lime	3248
Lime	3497
Lime & Shale	3615
Lime	4403
R.T.D.	4403

RECEIVED
STATE CORPORATION COMMISSION
DEC 27 1965
12-27-1965
COMMISSIONER
WICHITA, KANSAS

STATE OF KANSAS)
) SS
COUNTY OF SEDGWICK)

I, FRED S. BARKER, DO HEREBY CERTIFY THAT THE ABOVE IS A TRUE AND CORRECT COPY OF THE DRILLER'S LOG ON THE CROWELL #1, LOCATED IN THE NE NE OF SECTION 35-17S-32W, SCOTT COUNTY, KANSAS.

EARL F. WAKEFIELD

BY Fred Barker

SUBSCRIBED AND SWORN TO BEFORE ME THIS 23RD DAY OF NOVEMBER, 1965.

MY COMMISSION EXPIRES:
JANUARY 25, 1969

Wanda W. Riley
WANDA W. RILEY --- NOTARY PUBLIC