


WELL PLUGGING RECORD

Give All Information Completely
Make Required Affidavit
Mail or Deliver Report to:
Conservation Division
State Corporation Commission
212 No. Market
Wichita, Kansas

NORTH

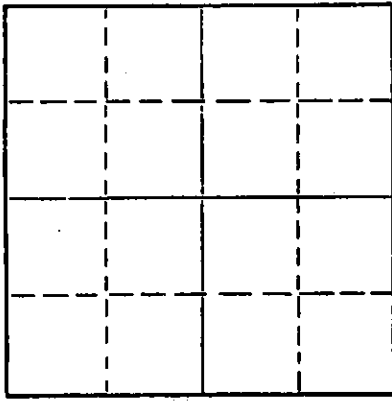

Locate well correctly on above
Section Plat

Scott County, Sec. 13 Twp. 17S Rge. 32 (E) (W)

Location as "NE/CNW&SW" or footage from lines C NW SE
Lease Owner Caldwell & Burch
Lease Name Griffith Well No. 1
Office Address Amarillo Building, Amarillo, Texas
Character of Well (completed as Oil, Gas or Dry Hole) Dry Hole
Date well completed October 19, 1959
Application for plugging filed October 19, 1959
Application for plugging approved October 19, 1959
Plugging commenced October 19, 1959
Plugging completed October 19, 1959
Reason for abandonment of well or producing formation Dry Hole

If a producing well is abandoned, date of last production None 19
Was permission obtained from the Conservation Division or its agents before plugging was commenced? Yes

Name of Conservation Agent who supervised plugging of this well M. A. Rives
Producing formation _____ Depth to top _____ Bottom _____ Total Depth of Well 4665 Feet
Show depth and thickness of all water, oil and gas formations.

OIL, GAS OR WATER RECORDS

CASING RECORD

| FORMATION | CONTENT | FROM | TO | SIZE | PUT IN | PULLED OUT |
|-----------|---------|------|----|--------|--------|------------|
| | | | | 8 5/8" | 274 | None |
| | | | | | | |
| | | | | | | |
| | | | | | | |
| | | | | | | |
| | | | | | | |
| | | | | | | |

Describe in detail the manner in which the well was plugged, indicating where the mud fluid was placed and the method or methods used in introducing it into the hole. If cement or other plugs were used, state the character of same and depth placed, from _____ feet to _____ feet for each plug set.

8 5/8 inch surface pipe set at 274 feet
and circulated with 250 sacks of cement.
Hole filled with heavy mud to 270 feet.
Set plug and displaced 20 sacks of cement
through drill pipe. Hole mudded to 35 feet;
Set plug and filled with cement to base of
cellar.

Cement pumped by Halliburton Cementing Company.

David
10-21-1959

(If additional description is necessary, use BACK of this sheet)

Name of Plugging Contractor Halliburton Cementing Company &
Address Tommy Ward Drilling Company, Oklahoma City, Oklahoma

STATE OF KANSAS, COUNTY OF SEDGWICK, ss.

(employee of owner) or (owner or operator) of the above-described well, being first duly sworn on oath, says: That I have knowledge of the facts, statements, and matters herein contained and the log of the above-described well as filed and that the same are true and correct. So help me God.

(Signature) Caldwell & Burch
Amarillo Building, Amarillo, Texas
(Address)

SUBSCRIBED AND SWORN to before me this _____ day of _____, 19____

My commission expires _____

Notary Public.

15-171-00010-00-00

Record
10-21-1959


WELL LOG BUREAU—KANSAS GEOLOGICAL SOCIETY
508 East Murdock, Wichita, Kansas

Company W. CALDWELL & BILL BURCH
Farm Griffith No. 1

SEC. 13 T. 17 R. 32W
C NW SE

Total Depth. 4665'
Comm. 10-1-59 Comp. 10-30-59
Shot or Treated.
Contractor. Tommy Ward Drlg.
Issued. 3-11-61

County Scott
KANSAS

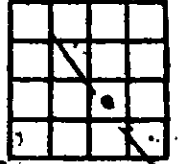

CASINO:
8" 271'

Elevation. 2971' RB

Production. Dry

Figures Indicate Bottom of Formations.

COMPLETE DRILLERS LOG NOT AVAILABLE

| | |
|--------------|------|
| TOPS: SCOUT | |
| Lansing | 3983 |
| Marnaton | 4402 |
| Mississippi | 4630 |
| Total Depth. | 4665 |