


15-171-20184-00-00

STATE OF KANSAS  
STATE CORPORATION COMMISSION

WELL PLUGGING RECORD

Give All Information Completely  
Make Required Affidavit  
Mail or Deliver Report to  
Conservation Division  
State Corporation Comm.  
245 North Water  
Wichita, KS 67202

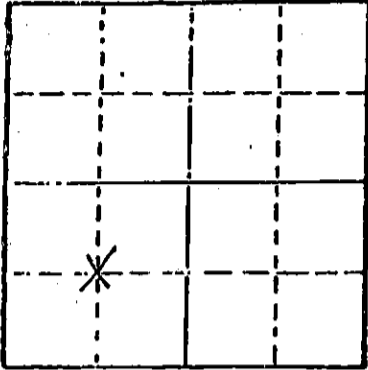

Locate well correctly on above  
Section Plot

Scott County. Sec. 36 Twp. 19 Rge. 33 E/W  
Location as "NE/CNW $\frac{1}{4}$ SW $\frac{1}{4}$ " or footage from lines \_\_\_\_\_  
Center of SW \_\_\_\_\_

Lease Owner The Prudential Energy Company  
Lease Name Barnhart Well No. 36-1  
Office Address 1300 Main St. Suite 1644, Houston, Tx. 77002  
Character of Well (Completed as Oil, Gas or Dry Hole) \_\_\_\_\_

Dry hole  
Date Well completed 1-31- 1980  
Application for plugging filed 1-31 1980  
Application for plugging approved 1-31 1980  
Plugging commenced 10 A.M. 1-31- 1980  
Plugging completed 11:45 A.M. 1-31- 1980  
Reason for abandonment of well or producing formation \_\_\_\_\_

Dry Hole  
If a producing well is abandoned, date of last production \_\_\_\_\_ 19\_\_\_\_

Was permission obtained from the Conservation Division or its agents before plugging was commenced? Yes

Name of Conservation Agent who supervised plugging of this well Gilbert Balthazon  
Producing formation \_\_\_\_\_ Depth to top \_\_\_\_\_ Bottom \_\_\_\_\_ Total Depth of Well \_\_\_\_\_  
Show depth and thickness of all water, oil and gas formations.

OIL, GAS OR WATER RECORDS

CASING RECORD

FORMATION	CONTENT	FROM	TO	SIZE	PUT IN	PULLED OUT
Surface	Sd & Shale	0	258	8 5/8"	X	Left

Describe in detail the manner in which the well was plugged, indicating where the mud fluid was placed and the method or methods used in introducing it into the hold. If cement or other plugs were used, state the character of same and depth placed, from \_\_\_\_\_ feet to \_\_\_\_\_ feet for each plug-set.

- Cement with 105 Sx. 50/50 Poz with 6% Gel.
- 70 Sx. @ 900'
- 20 Sx. @ 240'
- 10 Sx @ 40' to 0
- 5 Sx. Rathole

RECEIVED  
FEB 11 1980  
STATE CORPORATION COMMISSION  
02-11-80

(If additional description is necessary, use BACK of this sheet)

Name of Plugging Contractor Lakin Drilling Co.

STATE OF Texas COUNTY OF Dallas, ss.  
Steve Brazeal (employee of owner) or (owner or operator)

of the above-described well, being first duly sworn on oath, says: That I have knowledge of the facts, statements, and matters herein contained and the log of the above-described well as filed and that the same are true and correct. So help me God.

(Signature) Steve Brazeal  
292 Meadows Bldg., Dallas, Texas 75206  
(Address)

SUBSCRIBED AND SWORN TO before me this 8th day of February, 1980

Patricia K. McMahan  
Notary Public.

commission expires Sept. 29, 1980