


15-171-30007-00-00

Give All Information Completely  
Make Required Affidavit  
Mail or Deliver Report to:  
Conservation Division  
State Corporation Commission  
211 No. Broadway  
Wichita, Kansas

WELL PLUGGING RECORD

Scott County, Sec. 35 Twp. 19s Rge. 33w (E) (W)

Location as "NE/CNW/SW" or footage from lines. c - ne 1/4  
Lease Owner Saburn Oil and Gas Co.  
Lease Name Smith Well No. 2 - 35  
Office Address Box 176 Cheyenne, Wyoming  
Character of Well (completed as Oil, Gas or Dry Hole) Dry  
Date well completed 5 - 8 - 65 19 65  
Application for plugging filed 5 - 12 - 19 65  
Application for plugging approved 5 - 15 19 65  
Plugging commenced 5 - 17 19 65  
Plugging completed 5 - 18 19 65  
Reason for abandonment of well or producing formation Not enough gas

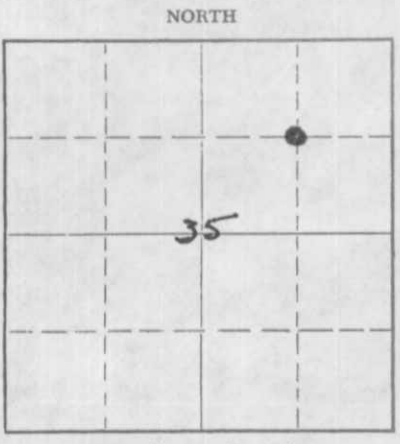

Locate well correctly on above Section Plat

If a producing well is abandoned, date of last production \_\_\_\_\_ 19\_\_\_\_  
Was permission obtained from the Conservation Division or its agents before plugging was commenced? Yes

Name of Conservation Agent who supervised plugging of this well W. L. Nichols  
Producing formation \_\_\_\_\_ Depth to top \_\_\_\_\_ Bottom \_\_\_\_\_ Total Depth of Well 2668 Feet  
Show depth and thickness of all water, oil and gas formations.

OIL, GAS OR WATER RECORDS

CASING RECORD

FORMATION	CONTENT	FROM	TO	SIZE	PUT IN	PULLED OUT
				8 5/8	348	none
				4 1/2	2668	2200'

Describe in detail the manner in which the well was plugged, indicating where the mud fluid was placed and the method or methods used in introducing it into the hole. If cement or other plugs were used, state the character of same and depth placed, from \_\_\_\_\_ feet to \_\_\_\_\_ feet for each plug set.

Mix 10 sacks cement to plug off perforations and stop plug at 2410'. Pull 4 1/2" to 600 feet and circulate with mud, pull 4 1/2" to 540 feet and displace 20 sacks cement. Pull 4 1/2" to 275 and displace 20 sacks cement. Finish pulling 4 1/2" casing. Bridge at 35 feet and 10 sacks cement on top.

RECEIVED  
STATE CORPORATION COMMISSION  
JUN 1 1965  
06-01-65  
CONSERVATION DIVISION  
Wichita, Kansas

(If additional description is necessary, use BACK of this sheet)  
Name of Plugging Contractor Sargent's Casing Pulling Service  
Address Box 506 Liberal, Kansas

STATE OF KANSAS, COUNTY OF SEWARD, ss.  
DONALD W. JACKSON (employee of owner) ~~or (owner or operator)~~ of the above-described well, being first duly sworn on oath, says: That I have knowledge of the facts, statements, and matters herein contained and the log of the above-described well as filed and that the same are true and correct. So help me God.

(Signature) Donald W. Jackson  
1411 North Carlton  
(Address)

SUBSCRIBED AND SWORN TO before me this 28th day of May, 1965

My commission expires 11-23-66  
Albert S. Smith  
Notary Public.



LEASE: SMITH NO. 2-35  
 OWNER: SATURN OIL & GAS COMPANY  
 CONT: EARL F. WAKEFIELD  
 COMM: 5-1-65  
 COMP: 5-4-65

LOCATION: NE/4  
 SECTION 35-198-33W  
 SCOTT COUNTY, KANSAS  
 CASING: 8 5/8" Set @ 348'  
 4 1/2" Set @ 2670'

Surface Soil	65
Sand & Clay	190
Blue Shale	352
Shells & Clay, Red Bed	1396
Shale & Anhydrite	1600
Salt & Shale	1885
Shale & Shells	2050
Shale	2168
Anhydrite	2188
Shale	2290
Shale & Lime	2635
Lime & Shale	2670
R.T.D.	2670

**RECEIVED**  
 STATE CORPORATION COMMISSION  
 JUN 1 1965  
 CONSERVATION DIVISION  
 Wichita, Kansas

STATE OF KANSAS )  
 ) SS  
 COUNTY OF SEDGWICK )

I, FRED S. BARKER, DO HEREBY CERTIFY THAT THE ABOVE IS A TRUE AND CORRECT COPY OF THE DRILLER'S LOG ON THE SMITH #2-35, LOCATED IN THE NE/4 OF SECTION 35-198-33W, SCOTT COUNTY, KANSAS.

EARL F. WAKEFIELD

BY Fred S. Barker  
 Fred S. Barker

SUBSCRIBED AND SWORN TO BEFORE ME THIS 14TH DAY OF MAY, 1965.

MY COMMISSION EXPIRES:  
JANUARY 25, 1969

Wanda H. Riley  
 NOTARY PUBLIC