


Give All Information Completely
Make Required Affidavit
Mail or Deliver Report to:
Conservation Division
State Corporation Commission
211 No. Broadway
Wichita, Kansas

WELL PLUGGING RECORD

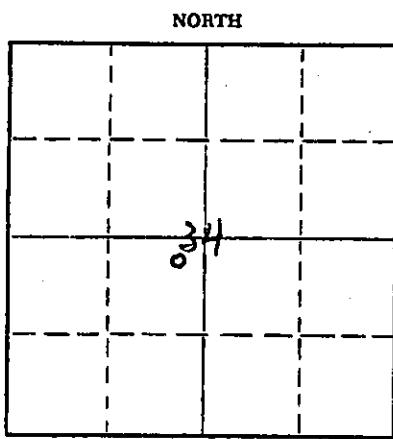

Locate well correctly on above Section Plat

Location as "NE/CNW/SW" or footage from lines SW/4
 Lease Owner Saturn Oil & Gas Company, Inc.
 Lease Name Patton Well No. 1-34
 Office Address Box 176 Cheyenne, Wyoming
 Character of Well (completed as Oil, Gas or Dry Hole) Dry Hole
 Date well completed February 16, 1965
 Application for plugging filed February 16, 1965
 Application for plugging approved February 16, 1965
 Plugging commenced February 16, 1965
 Plugging completed February 16, 1965
 Reason for abandonment of well or producing formation _____

If a producing well is abandoned, date of last production _____ 19____
 Was permission obtained from the Conservation Division or its agents before plugging was commenced? Yes

Name of Conservation Agent who supervised plugging of this well W.L. Nichols
 Producing formation None Depth to top _____ Bottom _____ Total Depth of Well 2909 Feet
 Show depth and thickness of all water, oil and gas formations.

OIL, GAS OR WATER RECORDS

CASING RECORD

| FORMATION | CONTENT | FROM | TO | SIZE | PUT IN | PULLED OUT |
|----------------|----------|----------------|----|------------------------------------|--------|------------|
| Not available. | Old well | --washed down. | | 10 3/4 | 248 | None |
| | | | | This casing was installed in 1944. | | |
| | | | | | | |
| | | | | | | |
| | | | | | | |

Describe in detail the manner in which the well was plugged, indicating where the mud fluid was placed and the method or methods used in introducing it into the hole. If cement or other plugs were used, state the character of same and depth placed, from _____ feet to _____ feet for each plug set.

Filled with mud from 2909 to 660'
 Cement plug from 660 to 575' (30 sacks)
 Mud from 575 to 240'
 Cement Plug from 240 to 175' (30 sacks)
 Mud from 175 to 40'
 Cement Plug from 40 to Surface (10 sacks)

RECEIVED
STATE CORPORATION COMMISSION

FEB 26 1965

02-26-65

CONSERVATION DIVISION
Wichita, Kansas

Name of Plugging Contractor Earl F. Wakefield
 Address 515 Union Center Building, Wichita, Kansas

STATE OF Kansas, COUNTY OF Seward, ss.
Donald W. Jackson (employee of owner) or (owner or operator) of the above-described well, being first duly sworn on oath, says: That I have knowledge of the facts, statements, and matters herein contained and the log of the above-described well as filed and that the same are true and correct. So help me God.

(Signature) Donald W. Jackson
111 N. Carlton, Liberal, Kansas
 (Address)

SUBSCRIBED AND SWORN to before me this 24th day of February, 19 65

My commission expires 12-28-68

Notary Public.