

15-175-01004-00-00

STATE OF KANSAS
STATE CORPORATION COMMISSION
CONSERVATION DIVISION
P. O. BOX 17027
WICHITA, KANSAS 67217

FORM CP-4

WELL PLUGGING RECORD

API #15-175-30097

Seward County, Sec. 33 Twp. 33S Rge. ~~33~~ 32 (W)

Location as "NE/CNW/SW" or footage from lines C/SE NW

Lease Owner Gulf Oil Corporation

Lease Name Alexander Heirs Well No. 1

Office Address P.O. Box 12116, Oklahoma City, OK 73157

Character of Well (completed as Oil, Gas or Dry Hole) gas

Date well completed April of 19 66

Application for plugging filed March 24 19 80

Application for plugging approved March 26 19 80


Plugging commenced June 18 19 80

Plugging completed June 19 19 80

Reason for abandonment of well or producing formation uneconomical to produce

If a producing well is abandoned, date of last production June 17 19 80

Was permission obtained from the Conservation Division or its agents before plugging was commenced? yes

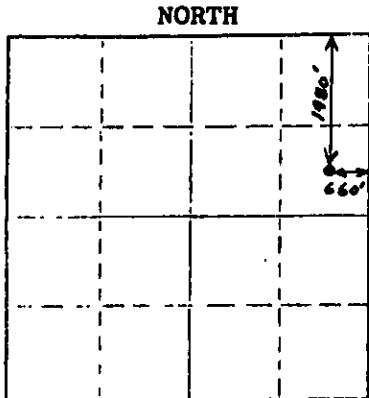

Locate well correctly on above Section Plat

Name of Conservation Agent who supervised plugging of this well Clarence Thomas

Producing formation Morrow Sand Depth to top 5758 Bottom 5785 Total Depth of Well 6150

Show depth and thickness of all water, oil and gas formations. PBTB 5877

OIL, GAS OR WATER RECORDS

CASING RECORD

FORMATION	CONTENT	FROM	TO	SIZE	PUT IN	PULLED OUT
Morrow Sand	Gas	5758	5761	20"	47'	0'
Morrow Sand	Gas	5782	5785	8-5/8"	1508'	0'
				4-1/2"	5917'	3456'

Describe in detail the manner in which the well was plugged, indicating where the mud fluid was placed and the method or methods used in introducing it into the hole. If cement or other plugs were used, state the character of same and depth placed, from feet to feet for each plug set.

- 6-18-80: Spot 15 sxs cmt 5877-5624' (253'). Fill casing w/mud. Laid down tubing.
- 6-19-80: Shot pipe @ 3567' but couldn't pull pipe. Shot pipe @ 3456'; pull 110,000# and pipe came free. Began LD casing.
- 6-20-80: Spot cmt plugs as follows: 25 sxs 1558-1458'; 25 sxs 750-650'; and 10 sxs 30-10'. Weld cap on surface pipe. Witnessed by KCC Supervisor. P&A'd at 2:30 p.m. on 06-19-80. Recovered 3456' of 4-1/2" 9.5# casing and 5754' of 2-3/8" tubing.

(If additional description is necessary, use BACK of this sheet)

Name of Plugging Contractor Dako, Inc.

Address 1406 South Cedar, Borger, TX 79007 (TELEPHONE: 806-848-2344)

STATE OF OKLAHOMA COUNTY OF OKLAHOMA

Dorretta Moore

(employee of ~~owner~~ or ~~operator~~) of the above-described

well, being first duly sworn on oath, says: That I have knowledge of the facts, statements, and matters herein contained and the log of the above-described well as filed and that the same are true and correct. So help me God.

(Signature) Dorretta Moore

P.O. Box 12116, Okla. City, OK 73157

(Address)

SUBSCRIBED AND SWORN TO before me this 12th day of August 19 80

Patricia J. Wonderly


Notary Public.

My commission expires 1-31-83

RECEIVED
STATE CORPORATION COMMISSION
AUG 18 1980
8-18-80
CONSERVATION DIVISION
Wichita, Kansas

WELL PLUGGING RECORD

API #15-175-30097

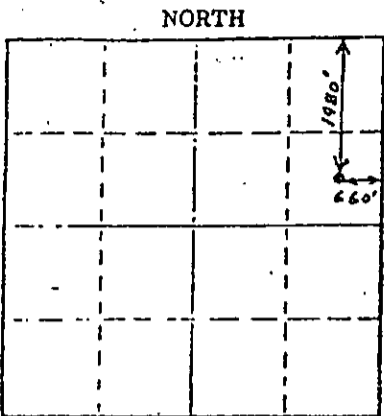

Locate well correctly on above Section Plat

Seward County, Sec. 33 Twp. 33S Rge. 32 (W)
 Location as "NE/CNW&SW" or footage from lines C/SE NW
 Lease Owner Gulf Oil Corporation
 Lease Name Alexander Heirs Well No. 1
 Office Address P.O. Box 12116, Oklahoma City, OK 73157
 Character of Well (completed as Oil, Gas or Dry Hole) gas
 Date well completed April of 19 66
 Application for plugging filed March 24 19 80
 Application for plugging approved March 26 19 80
 Plugging commenced June 18 19 80
 Plugging completed June 19 19 80
 Reason for abandonment of well or producing formation uneconomical to produce

If a producing well is abandoned, date of last production June 17 19 80
 Was permission obtained from the Conservation Division or its agents before plugging was commenced? yes

Name of Conservation Agent who supervised plugging of this well Clarence Thomas
 Producing formation Morrow Sand Depth to top 5758 Bottom 5785 Total Depth of Well 6150
 Show depth and thickness of all water, oil and gas formations. PBT 5877

OIL, GAS OR WATER RECORDS				CASING RECORD		
FORMATION	CONTENT	FROM	TO	SIZE	PUT IN	PULLED OUT
Morrow Sand	Gas	5758	5761	20"	47'	0'
Morrow Sand	Gas	5782	5785	8-5/8"	1508'	0'
				4-1/2"	5917'	3456'

Describe in detail the manner in which the well was plugged, indicating where the mud fluid was placed and the method or methods used in introducing it into the hole. If cement or other plugs were used, state the character of same and depth placed, from _____ feet to _____ feet for each plug set.

6-18-80: Spot 15 sxs cmt 5877-5624' (253'). Fill casing w/mud. Laid down tubing.
 6-19-80: Shot pipe @ 3567' but couldn't pull pipe. Shot pipe @ 3456'; pull 110,000# and pipe came free. Began LD casing.
 6-20-80: Spot cmt plugs as follows: 25 sxs 1558-1458'; 25 sxs 750-650'; and 10 sxs 30-10'. Weld cap on surface pipe. Witnessed by KCC Supervisor. P&A'd at 2:30 p.m. on 06-19-80. Recovered 3456' of 4-1/2" 9.5# casing and 5754' of 2-3/8" tubing.

Name of Plugging Contractor Dako, Inc.
 Address 1406 South Cedar, Borger, TX 79007 (TELEPHONE: 806-848-2344)

STATE OF Oklahoma COUNTY OF Oklahoma
Dorretta Moore (employee of _____ operator) of the above-described

well, being first duly sworn on oath, says: That I have knowledge of the facts, statements, and matters herein contained and the log of the above-described well as filed and that the same are true and correct. So help me God.
 (Signature) Dorretta Moore

P.O. Box 12116, Okla. City, OK 73157
 (Address)

SWORN AND SWORN TO before me this 12th day of August, 19 80

My commission expires January 31, 1983

Patricia A. Wonderly
 Notary Public

RECEIVED
 STATE CORPORATION COMMISSION

AUG 25 1980

CONSERVATION DIVISION
 Wichita, Kansas

- 08-12-80 DISTRIBUTION: Original - KCC
 1 - WELL FILE
 1 - John Bagzis
 1 - Evie Keil
 1 - George L. Neubauer - Tax Department

1720 South Bellaire Street
 Denver, CO 80222

LEASE: ALEXANDER HEIRS #1
OWNER: GULF OIL CORPORATION
CONT: EARL F. WAKEFIELD
COMM: 3-7-66
COMP: 3-26-66

LOCATION: C SE NW
SECTION 33-33S-32W
SEWARD COUNTY, KANSAS
CASING: 8 5/8" SET @ 1508'
4 1/2" SET @ 5921'

Sand & Clay	400
Red Bed & Gyp	930
Red Bed & Sand	1310
Red Bed & Shells	1420
Lime & Shale & Anhydrite	1499
Shale & Anhydrite	2048
Shale & Lime	2096
Shale & Shells	2297
Lime & Shale	2700
Lime With Shale	2862
Lime & Shale	3630
Lime	3700
Lime & Shale	4005
Lime	4271
Lime & Shale	4425
Lime	5515
Lime & Shale	5795
Lime	5880
Lime & Shale	5930
Lime	6150
R.T.D.	6150

STATE OF KANSAS)
) SS
COUNTY OF SEDGWICK)

I, FRED S. BARKER, DO HEREBY CERTIFY THAT THE ABOVE IS A TRUE AND
CORRECT COPY OF THE DRILLER'S LOG ON THE ALEXANDER HEIRS #1, LOCATED
C SE NW OF SECTION 33-33S-32W, SEWARD COUNTY, KANSAS.

EARL F. WAKEFIELD

BY Fred S. Barker

SUBSCRIBED AND SWORN TO BEFORE ME THIS 6TH DAY OF APRIL, 1966

MY COMMISSION EXPIRES:
JANUARY 25, 1969

Wanda W. Riley
WANDA W. RILEY---NOTARY PUBLIC

RECEIVED
STATE OF KANSAS COMMISSION
MAR 26 1966
CONSERVATION DIVISION
Topeka, Kansas