


STATE OF KANSAS  
STATE CORPORATION COMMISSION

Give All Information Completely  
Make Required Affidavit  
Mail or Deliver Report to:  
Conservation Division  
State Corporation Commission  
212 No. Market  
Wichita, Kansas

15-171-20027-0006 Form CP-4  
WELL PLUGGING RECORD

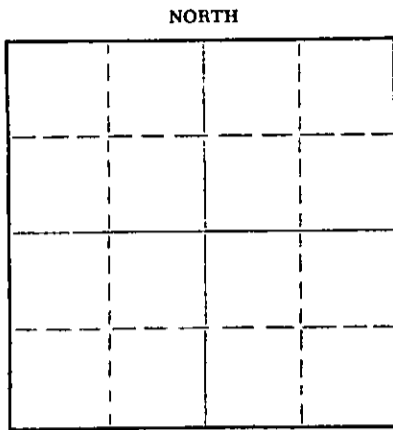

Locate well correctly on above Section Plat

Location as "NE/CNW/SW" or footage from lines Scott County, Sec. 28 Twp. 19S Rge. (E) 33 (W)  
Lease Owner Yucca Petroleum Company  
Lease Name Miller Well No. 1  
Office Address P. O. Box 2585, Amarillo, Texas 79105  
Character of Well (completed as Oil, Gas or Dry Hole) Dry Hole  
Date well completed October 19 1969  
Application for plugging filed October 19 1969  
Application for plugging approved October 19 1969  
Plugging commenced October 19 1969  
Plugging completed October 19 1969  
Reason for abandonment of well or producing formation Dry Hole

If a producing well is abandoned, date of last production \_\_\_\_\_ 19\_\_\_\_  
Was permission obtained from the Conservation Division or its agents before plugging was commenced? Yes

Name of Conservation Agent who supervised plugging of this well W. L. Nichols  
Producing formation \_\_\_\_\_ Depth to top \_\_\_\_\_ Bottom \_\_\_\_\_ Total Depth of Well 4850 Feet  
Show depth and thickness of all water, oil and gas formations.

OIL, GAS OR WATER RECORDS

CASING RECORD

FORMATION	CONTENT	FROM	TO	SIZE	PUT IN	PULLED OUT
				8 5/8"	367'	none

Describe in detail the manner in which the well was plugged, indicating where the mud fluid was placed and the method or methods used in introducing it into the hole. If cement or other plugs were used, state the character of same and depth placed, from \_\_\_\_\_ feet to \_\_\_\_\_ feet for each plug set.

Plugged hole @ 100' with 80 sacks cement  
Plugged hole @ 400' with 20 sacks cement  
1/2 sack hulls plug @ 40' with 10 sacks cement.


RECEIVED  
STATE CORPORATION COMMISSION  
OCT 28 1969  
CONSERVATION DIVISION  
Wichita, Kansas

(If additional description is necessary, use BACK of this sheet)  
Name of Plugging Contractor Leben Drilling, Inc.  
Address Box 486, Great Bend, Kansas 67530

STATE OF KANSAS COUNTY OF BARTON, ss.  
Leslie Kite (employee of owner) or (owner or operator) of the above-described well, being first duly sworn on oath, says: That I have knowledge of the facts, statements, and matters herein contained and the log of the above-described well as filed and that the same are true and correct. So help me God.

(Signature) Leslie Kite  
Box 486, Great Bend, Kansas  
(Address)

SUBSCRIBED AND SWORN to before me this 27th day of October 1969  
My commission expires April 1, 1971

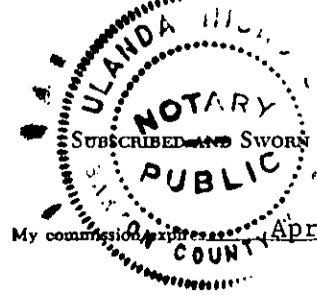

Ulanda Nichols  
Notary Public.

15-171-20027-00-00

DRILLER'S LOG

COMPANY  
CONTRACTOR  
FARM  
LOCATION  
  
COMMENCED  
COMPLETED

YUGGA PETROLEUM COMPANY  
LEBEN DRILLING, INC.  
MILLER #1  
C SW SW SECTION 28-19S-33W  
SCOTT COUNTY, KANSAS  
10-6-69  
10-19-69

0 148  
148 367  
367 1260  
1260 1940  
1940 2211  
2211 2229  
2229 2520  
2520 2968  
2968 4690  
4690 4749  
4749 4850  
4850

Clay, Sand  
Shale, Post Rock  
Shale  
Shale, Sand  
Shale, Red Bed  
Anhydrite  
Shale  
Shale, Lime  
Lime  
Lime, Miss  
Lime  
RTD

STATE DEPARTMENT OF  
CORPORATION COMMISSION  
OCT 28 1969  
CONSERVATION DIVISION  
Wichita, Kansas

8 5/8" 20# new surface casing set @ 367' cemented with 270 sacks common 3% cc,  
1/2# Flo cel per sack.

I, Leslie Kite, do hereby certify that the above and foregoing is a true and correct copy of the log of the Miller #1 Well, located C SW SW, Section 28, Township 19 South, Range 33 West, Scott County, Kansas, as reflected by the records of Leben Drilling, Inc.

Leslie Kite  
Leslie Kite

STATE OF KANSAS )  
                          ) ss  
COUNTY OF BARTON )

Subscribed and sworn to and before me, a Notary Public, inand for Barton County, Kansas, this 27th day of October, 1969.



Ulanda Nichols  
Ulanda Nichols