


STATE OF KANSAS
STATE CORPORATION COMMISSION

15-171-20020-00-01 Form CP-4
WELL PLUGGING RECORD

Give All Information Completely
Make Required Affidavit
Mail or Deliver Report to:
Conservation Division
State Corporation Commission
212 No. Market
Wichita, Kansas

Scott County, Sec. 27 Twp. 19S Rge. (E) 33W(W)

Location as "NE/CNW/SW" or footage from lines App C SE SE
Lease Owner Yucca Petroleum Company
Lease Name Irma Well No. 1
Office Address Box 2585
Character of Well (completed as Oil, Gas or Dry Hole) Dry Hole
Date well completed 4-28 19 69
Application for plugging filed 4-28- 19 69
Application for plugging approved 4-28 19 69
Plugging commenced 4-28 19 69
Plugging completed 4-28 19 69
Reason for abandonment of well or producing formation Dry Hole

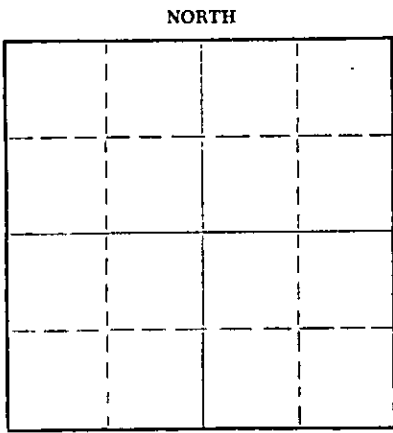

Locate well correctly on above Section Plat

If a producing well is abandoned, date of last production 19
Was permission obtained from the Conservation Division or its agents before plugging was commenced? Yes

Name of Conservation Agent who supervised plugging of this well W. L. Nichols
Producing formation Depth to top Bottom Total Depth of Well 4751 Feet
Show depth and thickness of all water, oil and gas formations.

OIL, GAS OR WATER RECORDS

CASING RECORD

FORMATION	CONTENT	FROM	TO	SIZE	PUT IN	PULLED OUT
				8 5/8"	274.57	none

Describe in detail the manner in which the well was plugged, indicating where the mud fluid was placed and the method or methods used in introducing it into the hole. If cement or other plugs were used, state the character of same and depth placed, from feet to feet for each plug set.

Plugged Spotted 100 sacks 50/50 Posmix 6% gel @ 920' Spotted 20 sacks 50/50 Posmix thru D.P. @ 400' Bridged @ 40' 10 sacks 1/2 hulls plug

RECEIVED
STATE CORPORATION COMMISSION
MAY 1 1969
CONSERVATION DIVISION
Wichita, Kansas

(If additional description is necessary, use BACK of this sheet)

Name of Plugging Contractor Leben Drilling, Inc.
Address Box 486, Great Bend, Kansas 67530

STATE OF KANSAS, COUNTY OF BARTON, ss.
Leslie Kite (employee of owner) or (owner or operator) of the above-described well, being first duly sworn on oath, says: That I have knowledge of the facts, statements, and matters herein contained and the log of the above-described well as filed and that the same are true and correct. So help me God.

(Signature) Leslie Kite

(Address)

SUBSCRIBED AND SWORN TO before me this 29th day of April 19 69

Ulanda Nichols

Notary Public.

My commission expires April 1, 1971

Ulanda Nichols

15-171-20020-0000

DRILLER'S LOG

COMPANY	Yucca Petroleum Company
CONTRACTOR	LEBEN DRILLING, INC.
FARM	IRMA #1
LOCATION	APP C SE SE SECTION 27-19S-33W SCOTT COUNTY, KANSAS
COMMENCED	4-16-69
COMPLETED	4-28-69

0	145	Clay, Sand, Gravel
145	375	Shale
375	1556	Shale, Sand
1556	2181	Red Bed, Sand, Shale
2181	2198	Anhydrite
2198	2273	Shale with Lime Str
2273	2960	Shale, Lime
2960	3972	Lime, Shale
3972	4751	Lime-
	<u>4751</u>	<u>RTD - D. & A.</u>

RECEIVED
STATE CORPORATION COMMISSION
MAY 1 1969
CONSERVATION DIVISION
Wichita, Kansas

8 5/8" 20# new surface casing set @ 274.57' cemented with 250 sacks Common cement, 2% cc

I, Leslie Kite, do hereby certify that the above and foregoing is a true and correct copy of the log of the Irma #1 Well, located App C SE SE of Section 27, Township 19 South, Range 33 West, Scott County, Kansas, as reflected by the records of Leben Drilling, Inc.

Leslie Kite
Leslie Kite

STATE OF KANSAS)
) SS
COUNTY OF BARTON)

Subscribed and sworn to and before me, a Notary Public, in and for Barton County, Kansas, this 29th day of April, 1969.

Ulanda Nichols
Ulanda Nichols

My Commission Expires:
April 1, 1971