


WELL PLUGGING RECORD

Give All Information Completely  
Make Required Affidavit  
Mail or Deliver Report to:  
Conservation Division  
State Corporation Commission  
211 No. Broadway  
Wichita, Kansas

NORTH

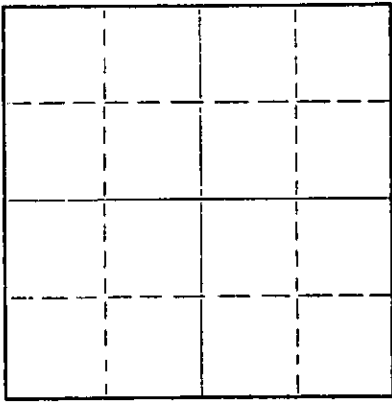

Locate well correctly on above  
Section Plat

Scott County. Sec. 35 Twp. 19S Rge. 34 ~~XXXX~~ (W)  
Location as "NE/CNW/SW" or footage from lines C/SW/SW/4  
Lease Owner E. K. Edmiston  
Lease Name Lang "B" Well No. 1  
Office Address 501 First Nat'l Bk. Bldg., Wichita 2, Kansas  
Character of Well (completed as Oil, Gas or Dry Hole) dry hole  
Date well completed June 6, 1963 19\_\_\_\_  
Application for plugging filed June 5, 1963 19\_\_\_\_  
Application for plugging approved June 5, 1963 19\_\_\_\_  
Plugging commenced June 5, 1963 19\_\_\_\_  
Plugging completed June 6, 1963 19\_\_\_\_  
Reason for abandonment of well or producing formation dry hole

If a producing well is abandoned, date of last production \_\_\_\_\_ 19\_\_\_\_  
Was permission obtained from the Conservation Division or its agents before plugging was commenced? yes

Name of Conservation Agent who supervised plugging of this well W. L. Nichols  
Producing formation \_\_\_\_\_ Depth to top \_\_\_\_\_ Bottom \_\_\_\_\_ Total Depth of Well 4980 Feet  
Show depth and thickness of all water, oil and gas formations.

OIL, GAS OR WATER RECORDS

CASING RECORD

FORMATION	CONTENT	FROM	TO	SIZE	PUT IN	PULLED OUT
				8-5/8"	360'	

Describe in detail the manner in which the well was plugged, indicating where the mud fluid was placed and the method or methods used in introducing it into the hole. If cement or other plugs were used, state the character of same and depth placed, from \_\_\_\_\_ feet to \_\_\_\_\_ feet for each plug set.

Plug 540' with 20 sacks cement  
350' " 20 " "  
40' " 10 " "

RECEIVED  
STATE CORPORATION COMMISSION

JUN 18 1963

CONSERVATION DIVISION  
Wichita, Kansas

(If additional description is necessary, use BACK of this sheet)

Name of Plugging Contractor E. K. Edmiston Drilling Co., Inc.  
Address 501 First National Bank Building, Wichita 2, Kansas

STATE OF Kansas, COUNTY OF Sedgwick, ss.  
E. K. Edmiston, operator ~~XXXXXX~~ of the above described

well, being first duly sworn on oath, says: That I have knowledge of the facts, statements, and matters herein contained and the log of the above-described well as filed and that the same are true and correct. So help me God.

(Signature) \_\_\_\_\_

501 First National Bank Building, Wichita,  
(Address) \_\_\_\_\_ Kansas

SUBSCRIBED AND SWORN TO before me this 17th day of June, 19 63

My commission expires August 25, 1964

G. B. Bergner  
Notary Public.



15-171-19036-00-00

DRILLER'S LOG

Company: E. K. Edmiston  
 501 First National Bank Building  
 Wichita 2, Kansas

Rotary Drilling Commenced: May 17, 1963

Rotary Drilling Completed: June 5, 1963

Well Name: Lang "B" No. 1  
 Center SW/4 SW/4 35-19S-34W  
 Scott County, Kansas

Contractor: E. K. Edmiston Drilling Co., Inc.  
 501 First National Bank Building  
 Wichita 2, Kansas

Casing Record: 8-5/8" @ 360' with 250 sacks cement

LOG

Measurements from top of Rotary Bushing

Surface Soil and Clay	0 - 75
Sand and Shale	358
Shale and Shells	700
Shale	1470
Shale and Shells	1800
Sand	1940
Shale and Red Bed	2260
Anhydrite	2295
Shale and Lime Streaks	2400
Shale and Lime	3314
Lime and Shale	3405
Shale and Lime	3695
Lime and Shale	3812
Chalk and Lime	3958
Lime and Shale	4058
Lime	4158
Lime and Shale	4572
Lime	4599
Shale and Lime	4661
Lime and Shale	4708
Lime	4945
Shale	4980 R.T.D.

RECEIVED  
 STATE CORPORATION COMMISSION  
 JUN 18 1963  
 CONSERVATION DIVISION  
 Wichita, Kansas

The undersigned, E. K. Edmiston, President of the E. K. Edmiston Drilling Company, Inc., hereby certifies, in behalf of said company, that the above log is a true and correct log of the formations encountered in drilling the above well as reflected by the daily drilling reports.

E. K. EDMISTON DRILLING CO., INC.  
 By [Signature]  
 E. K. Edmiston, President

STATE OF KANSAS,  
 SS:  
 SEDGWICK COUNTY,

BE IT REMEMBERED that on this 7th day of June, 1963, before me, the undersigned, a Notary Public duly commissioned in and for the State and County aforesaid, came E. K. Edmiston, known to me to be the same person who executed the foregoing instrument as President and on behalf of the E. K. Edmiston Drilling Co., Inc., and he duly acknowledged the execution of the same for himself and for said company.

IN WITNESS WHEREOF, I have hereunto set my hand and official seal on the day and year last above written.

My commission expires  
 August 25, 1964

[Signature]  
 A. B. Bargaen, Notary Public

