


15-17-20080-00-00

Give All Information Completely
Make Required Affidavit
Mail or Deliver Report to:
Conservation Division
State Corporation Commission

WELL PLUGGING RECORD

P. O. Box 17027
Wichita, Kansas 67217
NORTH

Scott County, Sec. 25 Twp. 19S Rge. (E) 34 (W)
Location as "NE/CNW&SW" or footage from lines. C SE NW
Lease Owner Maurice L. Brown Company
Lease Name Fairleigh Well No. 1
Office Address 1500 Vickers/KSB&T Bldg., Wichita
Character of Well (completed as Oil, Gas or Dry Hole) Dry Hole
Date well completed November 10, 1975
Application for plugging filed 19
Application for plugging approved 19
Plugging commenced November 10, 1975
Plugging completed November 10, 1975
Reason for abandonment of well or producing formation Dry Hole

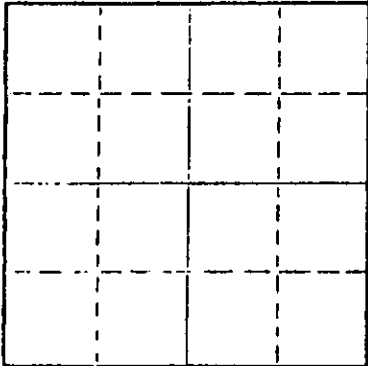

Locate well correctly on above
Section Plot

If a producing well is abandoned, date of last production 19
Was permission obtained from the Conservation Division or its agents before plugging was com-
menced? Yes (Gilbert Balthazor of Palco)

Name of Conservation Agent who supervised plugging of this well
Producing formation Depth to top Bottom Total Depth of Well 5067
Show depth and thickness of all water, oil and gas formations.

OIL, GAS OR WATER RECORDS

CASING RECORD

FORMATION	CONTENT	FROM	TO	SIZE	PUT IN	PULLED OUT
	Surface	0	356'	8-5/8"	356'	None
	Casing					

Describe in detail the manner in which the well was plugged, indicating where the mud fluid was placed and the method or methods used in introducing it into the hole. If cement or other plugs were used, state the character of same and depth placed, from feet to feet for each plug set.

Plugged Hole w/70 sax 50/50 Pozmix
@ 1000', 20 sax Pozmix @ 300' & 10
sax Pozmix 40' to 0. Job Completed
@ 4:30 P.M.

(If additional description is necessary, use BACK of this sheet)

Name of Plugging Contractor Halliburton
Address R.R. #1, Box 112, Liberal, Ks. 67901

STATE OF KANSAS COUNTY OF SEDGWICK
T. M. McCaul, Jr. of Sage Drilling Co.

being first duly sworn on oath, says: That I have knowledge of the facts, circumstances and matters herein contained and the log of the above-described well as filed and that the same are true and correct. So help me God.

(Signature) T. M. McCaul, Jr.
500 Bitting Bldg., Wichita, Kansas
(Address)

Subscribed and sworn to before me this 14th day of November 1975.

My commission expires November 26, 1978.

Louise K. Whitted - Notary Public.



RECEIVED
STATE CORPORATION COMMISSION

NOV 24 1975

CONSERVATION DIVISION
Wichita, Kansas

DRILLERS LOG

FAIRLEIGH NO. 1

CASING RECORD:	OPERATOR: Maurice L. Brown Company	DESCRIPTION:
8-5/8" set @ 356' w/300 sax cement	CONTRACTOR: Sage Drilling Co., Inc.	C SE NW Sec. 25-19S-34W Scott Co., Kans.
TOTAL DEPTH:	COMMENCED: October 26, 1975	ELEVATION: 3017KB
5067'	COMPLETED: November 10, 1975	

<u>FORMATION</u>	<u>FROM</u>	<u>TO</u>	<u>REMARKS</u>
Sand & Shale	0	361	
Shale	361	450	
Shale & Sand	450	2689	
Shale & Lime	2689	2825	
Lime & Shale	2825	3070	
Shale & Lime	3070	3260	
Lime & Shale	3260	3625	
Shale & Lime	3625	3880	
Lime & Shale	3880	4060	
Lime	4060	4205	
Shale & Lime	4205	4310	
Lime	4310	5067	D&A

RECORDED
STATE COMMISSION
NOV 24 1975
COMMERCIAL RECORDS
WILLIAM, KANSAS

I certify that this is a true and correct copy of the above log to the best of my knowledge.

SAGE DRILLING CO., INC.

By T. M. McCaul, Jr.
T. M. McCaul, Jr.



Subscribed and sworn to before me this 14th day of November, 1975.

Louise K. Whitted
Louise K. Whitted - Notary Public

My commission expires:
November 26, 1978.