

15-171-20190-00-80


STATE OF KANSAS
STATE CORPORATION COMMISSION

WELL PLUGGING RECORD

Give All Information Completely
Make Required Affidavit
Mail or Deliver Report to
Conservation Division
State Corporation Comm.
245 North Water
Wichita, KS 67202

copy of

Scott County, Sec. 22 Twp. 19S Rge. 34 XR/W
Location as "NE/CNW $\frac{1}{4}$ SW $\frac{1}{4}$ " or footage from lines
1980' FEL - 2270' FNL
Lease Owner Wichita Industries
Lease Name FARR Well No. 1
Office Address 475 - 17th St., Denver, CO 80202
Character of Well (Completed as Oil, Gas or Dry Hole) DRY HOLE
Date Well completed 11/9 1980
Application for plugging filed 11/10 1980
Application for plugging approved 19
Plugging commenced 11/10 1980
Plugging completed 11/10 1980
Reason for abandonment of well or producing formation DRY
If a producing well is abandoned, date of last production --- 19

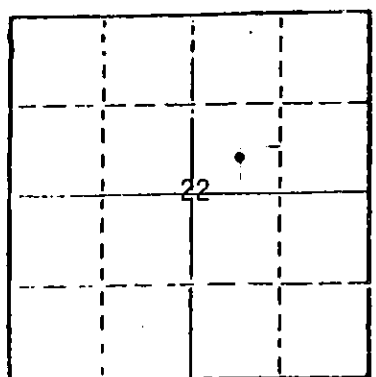

Locate well correctly on above Section Plot

Was permission obtained from the Conservation Division or its agents before plugging was commenced? Yes

Name of Conservation Agent who supervised plugging of this well Gil Balthazar, Palco, KS
Producing formation - Depth to top - Bottom - Total Depth of Well 5020'
Show depth and thickness of all water, oil and gas formations.

OIL, GAS OR WATER RECORDS

CASING RECORD

FORMATION	CONTENT	FROM	TO	SIZE	PUT IN	PULLED OUT
		0	560'	12 $\frac{1}{4}$ "	529.48'	NONE

Describe in detail the manner in which the well was plugged, indicating where the mud fluid was placed and the method or methods used in introducing it into the hold. If cement or other plugs were used, state the character of same and depth placed, from feet to feet for each plug set.

Plugged well with 60 sack plug at 830' to 730'; 30 sack plug at 530' to 480'; 10 sack plug at 40' to 0'. 5 sack plug in Rathole, 5 sack plug in Mousehole. Job complete at 10:15 AM 11/10/80.


(If additional description is necessary, use BACK of this sheet)

Name of Plugging Contractor Dowell - Ulysses, KS 67880

STATE OF Kansas COUNTY OF Seward, ss.
R.J. Patrick (employee of owner) or (owner or operator)
of the above-described well, being first duly sworn on oath, says: That I have knowledge of the facts, statements, and matters herein contained and the log of the above-described well as filed and that the same are true and correct. So help me God.

(Signature) *R.J. Patrick*
P.O. Box 1157, Liberal, KS 67901
(Address)

SUBSCRIBED AND SWORN TO before me this 12th day of November, 1980

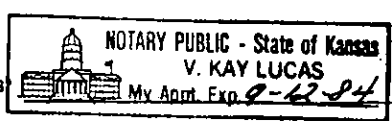

V. Kay Lucas
Notary Public.

My commission expires

15-171-20190-00-00

DRILLER'S LOG

Wichita Industries

FARR #1
1980' FEL-2270' FNL Sec. 22-19S-34W
Scott County, Kansas

Surface Casing: Drilled 560' of 12 1/2" hole. Ran
17 jts of 8-5/8" 24# Surface
Casing, 529.48' OA, set @527'. Cemented with
200 sks 35-60 Pozmix, 6% gel, 2% CC, 1/4# Celoflake;
150 sks Class H, 3% CC. Plug down at 7:40 AM
10/30/80. Cement circulated

Commenced: October 29, 1980
Completed: November 9, 1980

Total Depth: 5020'

FORMATION	FROM	TO	REMARKS
Sand	0'	560'	
Sand, Red Bed	560'	900'	
Red Bed, Sand	900'	1500'	
Red Bed	1500'	2318'	
Shale	2318'	2670'	
Shale, Lime	2670'	3100'	
Lime, Shale	3100'	3690'	
Shale	3690'	4010'	
Shale, Lime	4010'	4478'	
Lime, Shale	4478'	4772'	
Shale, Lime	4772'	4869'	
Lime	4869'	5007'	RTD 5020'
Lime, Shale	5007'	5020'	LTD 5018'
RTD		5020'	P&A

I certify that this is a true and correct copy of the log on the above captioned well to the best of my knowledge.

NRG Drilling, Inc.

By R.J. Patrick
R.J. Patrick, President

Subscribed and sworn to before me this 12th day of November NOV 11 1980

V. Kay Lucas
Notary Public

My commission expires:

