

CARD MUST BE TYPED

State of Kansas  
**NOTICE OF INTENTION TO DRILL**

(see rules on reverse side)

*Collectors*  
CARD MUST BE SIGNED

Starting Date: September 3, 1985  
month day year *2:01*

OPERATOR: License # 5171  
Name TXQ Production Corp.  
Address 1800 Lincoln Center Bldg.  
City/State/Zip Denver, Colorado 80264  
Contact Person Frank Tsuru  
Phone 303-861-4246

CONTRACTOR: License # Unknown  
Name  
City/State

Well Drilled For: Well Class: Type Equipment:  
 OH  Swd  Infield  Mud Rotary  
 Gas  Inj  Pool Ext.  Air Rotary  
 OWWO  Expl  Wildcat  Cable

If OWWO: old well info as follows:  
Operator  
Well Name  
Comp Date Old Total Depth  
Projected Total Depth 5300 feet  
Projected Formation at TD Morrow  
Expected Producing Formations Morrow

I certify that we will comply with K.S.A. 55-101, et seq., plus eventually plugging hole to K.C.C. specifications.

Date 9-3-85 Signature of Operator or Agent Frank Tsuru

API Number 15- 071-20,390-00-00

NE SE SE... Sec 1.. Twp 16.. S, Rge 43..  East  
(location)  West

.990 Ft North from Southeast Corner of Section  
*\* 990-330* Ft West from Southeast Corner of Section  
(Note: Locate well on Section Plat on reverse side)

Nearest lease or unit boundary line 330 feet.  
County Greeley  
Lease Name Edsall 'F' Well# 7

Domestic well within 330 feet:  yes  no  
Municipal well within one mile:  yes  no

Depth to Bottom of fresh water 300 feet  
Lowest usable water formation  
Depth to Bottom of usable water 1700 feet  
Surface pipe by Alternate: 1  2   
Surface pipe to be set 350 feet

Conductor pipe if any required  
Ground surface elevation TBD feet MSL  
This Authorization Expires 3-3-86

Approved By 9-3-85  
*Production string to be*  
*cont from below cashble*  
*into surface*  
Title Drilling Engineer

*\* was: 990 FEL*

Must be filed with the K.C.C. five (5) days prior to commencing well  
This card void if drilling not started within six (6) months of date received by K.C.C.

09-03-1985

Important procedures to follow:

A Regular Section of Land  
1 Mile = 5,280 Ft.

STATE

RECEIVED  
CORPORATION COMMISSION

District office before setting surface casing.

Set surface casing by circulating cement to the top.

3. File completion forms ACO-1 with K.C.C. within 90 days of well completion, following instructions on ACO-1, side 1, and including copies of wireline logs.

4. Notify District office 48 hours prior to old well workover or re-entry.


5. Prior to plugging, prepare a plugging plan, then obtain agreement from the appropriate district office for an approved plugging plan.

6. Submit plugging report (CP-4) to K.C.C. after plugging is completed.

7. Obtain an approved injection docket number before disposing of salt water.

8. Notify K.C.C. within 10 days when injection commences or terminates.

9. If an alternate 2 completion, cement in the production pipe from below any usable water to surface within 120 days of spud date.

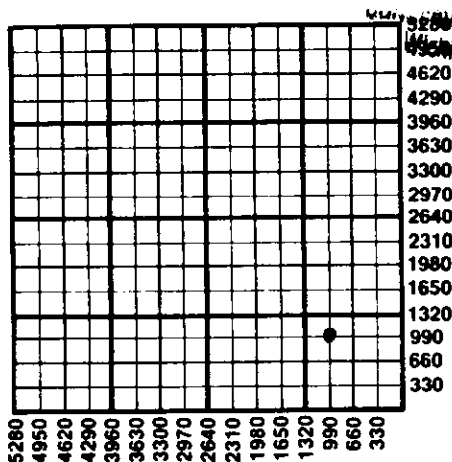

State Corporation Commission of Kansas  
Conservation Division  
200 Colorado Derby Building  
Wichita, Kansas 67202  
(316) 263-3238