

CARD MUST BE TYPED

State of Kansas
NOTICE OF INTENTION TO DRILL

(see rules on reverse side)

CARD MUST BE SIGNED

CORRECTED
9-27-85

Starting Date Immediately
month day year

API Number 15— 071-20,396-00-00

OPERATOR: License # 5171
Name TXO Production Corp.
Address 1800 Lincoln Center Bldg.
City/State/Zip Denver Colorado 80264
Contact Person Frank D. Tsuru
Phone (303) 861-4246

* NE NE NE Sec. 1 Twp. 16 S. Rg. 43 East
4950' West
* 330' Ft. from South Line of Section
Ft. from East Line of Section

(Note: Locate well on Section Plat on reverse side)

CONTRACTOR: License # Unknown
Name Unknown
City/State

Nearest lease or unit boundary line 330' feet
County Greeley
Lease Name Edsall "F" Well # 9

Well Drilled For: Well Class: Type Equipment:
 Oil SWD Infield Mud Rotary
 Gas Inj Pool Ext. Air Rotary
 OWWO Expl Wildcat Cable

Ground surface elevation TBD feet MSL
Domestic well within 330 feet: yes no
Municipal well within one mile: yes no
Surface pipe by Alternate: 1 2 [redacted]
Depth to bottom of fresh water 300'
Depth to bottom of usable water 1700'
Surface pipe planned to be set 350'
Projected Total Depth 5300' feet
Formation Morrow

If OWWO: old well info as follows:
Operator

I certify that well will comply with K.S.A. 55-101, et seq., plus eventually plugging hole to KCC specifications. K095 NW NW NW
4950 FEL

Date 9/24/85 Signature of Operator or Agent Frank D. Tsuru Title 9/24/85


For KCC Use:
Conductor Pipe Required feet; Minimum Surface Pipe Required feet per Alt. 1 2
This Authorization Expires 3-10-86 Approved By 9-10-85

Must be filed with the K.C.C. five (5) days prior to commencing well
This card void if drilling not started within six (6) months of date received by K.C.C.

Important procedures to follow:

1. Notify District office before setting surface casing.
2. Set surface casing by circulating cement to the top.
3. File completion forms ACO-1 with K.C.C. within 90 days of well completion, following instructions on ACO-1, side 1, and including copies of wireline logs.
4. Notify District office 48 hours prior to old well workover or re-entry.
5. Prior to filing Intent, prepare a proposed plugging plan in case well is D & A, then obtain approval of plan when calling district office prior to setting surface pipe.
6. Submit plugging report (CP-4) to K.C.C. after plugging is completed.
7. Obtain an approved injection docket number before disposing of salt water.
8. Notify K.C.C. within 10 days when injection commences or terminates.
9. If an alternate 2 completion, cement in the production pipe from below any usable water to surface within 120 days of spud date.

A Regular Section of Land
1 Mile = 5,280 Ft.

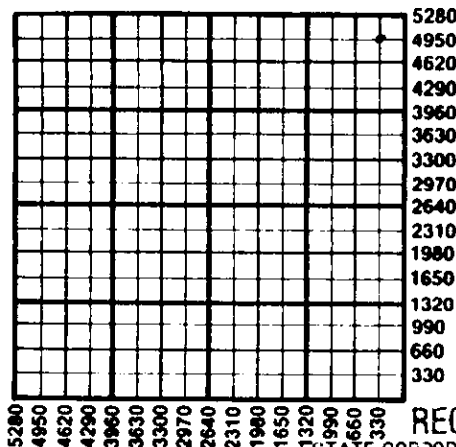

RECEIVED
STATE CORPORATION COMMISSION

SEP 27 1985
09-27-1985
CONSERVATION DIVISION
Wichita, Kansas

State Corporation Commission of Kansas
Conservation Division
200 Colorado Derby Building
Wichita, Kansas 67202
(316) 263-3238