

NOTICE OF INTENTION TO DRILL

(see rules on reverse side)

COLLECTION  
1-21-86

Starting Date ..... 1 21 86  
month day year

API Number 15— 071-20,415-00-00

OPERATOR: License # 5171  
Name TXO Production Corp.  
Address 1800 Lincoln Center Bldg.  
City/State/Zip Denver, Colorado 80264  
Contact Person Frank D. Tsuru  
Phone (303) 861-4246

East  
 West  
W/2 NE SE Sec. 1 Twp. 16 S. Rg. 43  
\* 1980' Ft. from South Line of Section  
\* 990' Ft. from East Line of Section

(Note: Locate well on Section Plat on reverse side)

CONTRACTOR: License # 6033  
Name Murfin Drilling Company, Inc.  
City/State Wichita, Kansas

Nearest lease or unit boundary line ..... 990 feet  
County Greeley  
Lease Name Edsall Well # F-15  
Ground surface elevation 3890 (EST) feet MSL  
Domestic well within 330 feet: —yes  no  
Municipal well within one mile: —yes  no  
Surface pipe by Alternate: 1 — 2   
Depth to bottom of fresh water ..... 300'  
Depth to bottom of usable water ..... 1700'  
Surface pipe planned to be set ..... ±350'  
Projected Total Depth ..... 5300' feet  
Formation Mississippian

Well Drilled For: Well Class: Type Equipment:  
 Oil — SWD — Infield — Mud Rotary  
— Gas — Inj  Pool Ext. — Air Rotary  
— OWWO — Expl — Wildcat — Cable

If OWWO: old well info as follows:  
Operator .....  
Well Name .....  
Comp Date ..... Old Total Depth .....

I certify that well will comply with K.S.A. 55-101, et seq., plus eventually plugging hole to KCC specifications. *was SW NESE*  
\_\_\_\_\_ cementing will be done immediately upon setting production casing. *1650 FSL*  
Date 1/13/86 Signature of Operator or Agent *Frank D. Tsuru* Title Drlg. & Prod. Engineer


For KCC Use:  
Conductor Pipe Required ..... feet; Minimum Surface Pipe Required ..... feet per Alt. 1 2  
This Authorization Expires 6-9-86 Approved By 12-9-85

Must be filed with the K.C.C. five (5) days prior to commencing well  
This card void if drilling not started within six (6) months of date received by K.C.C.

**Important procedures to follow:**

1. Notify District office before setting surface casing.
2. Set surface casing by circulating cement to the top.
3. File completion forms ACO-1 with K.C.C. within 90 days of well completion, following instructions on ACO-1, side 1, and including copies of wireline logs.
4. Notify District office 48 hours prior to old well workover or re-entry.
5. Prior to filing Intent, prepare a proposed plugging plan in case well is D & A, then obtain approval of plan when calling district office prior to setting surface pipe.
6. Submit plugging report (CP-4) to K.C.C. after plugging is completed.
7. Obtain an approved injection docket number before disposing of salt water.
8. Notify K.C.C. within 10 days when injection commences or terminates.
9. If an alternate 2 completion, cement in the production pipe from below any usable water to surface within 120 days of spud date.

**A Regular Section of Land**  
**1 Mile = 5,280 Ft.**

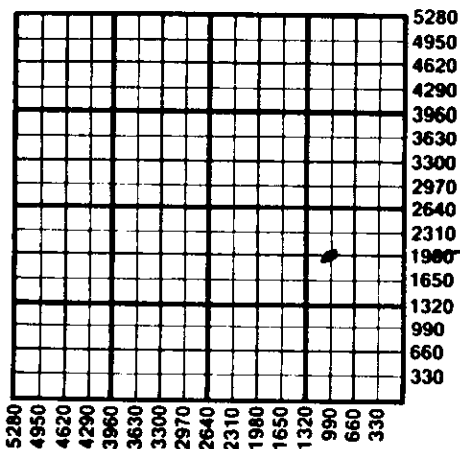

RECEIVED  
STATE CORPORATION COMMISSION

JAN 17 1986  
01-17-1986  
CONSERVATION DIVISION

State Corporation Commission of Kansas  
Conservation Division  
200 Colorado Derby Building  
Wichita, Kansas 67202  
(316) 263-3238