

15-169-20104-00-00

STATE OF KANSAS  
STATE CORPORATION COMMISSION  
200 Colorado Derby Bldg.  
Wichita, Kansas 67202

Form CP-4  
Rev. 12-15-80

WELL PLUGGING RECORD

Give All Information Completely  
Make Required Affidavit

COUNTY Saline SEC. 33 TWP. 14 RGE. 2 E/W  
Location as in quarters or footage from lines:  
C E/2 NW


Lease Owner Range Oil Co. Inc.  
Lease Name Weller Well No. 1  
Office Address 240 Page Court 220 West Douglas Wichita Ks.  
Character of Well (Completed as Oil, Gas or Dry Hole): Dry Hole  
Date Well Completed \_\_\_\_\_  
Application for plugging filed 6-8-81  
Plugging commenced 9-4-81  
Plugging completed 9-11-81  
Reason for abandonment of well or producing formation Dry Hole

Locate Well  
correctly on above  
Section Platt.

Was permission obtained from the Conservation Division or it's  
Agent's before plugging was commenced? Yes

Name of Conservation Agent who supervised plugging of this well Toman  
Producing formation \_\_\_\_\_ Depth to top \_\_\_\_\_ bottom \_\_\_\_\_ T.D. 3290  
Show depth and thickness of all water, oil and gas formations.

OIL, GAS OR WATER RECORDS

Casing Record

Formation	Content	From	To	Size	Put in	Pulled Out
				8 5/8	210	none
				4 1/2	3289	2651

Describe in detail the manner in which the well was plugged, indicating where the mud  
fluid was placed and the method or methods used in introducing it into the hold. If cement  
or other plugs were used, state the character of same and depth placed, from \_\_\_\_\_ feet  
to \_\_\_\_\_ feet for each plug set.

Sanded Hole to 3240' set four sks. cement with bailer  
Recovered 2651' of 4 1/2" casing  
Pumped four sks. hulls 20 sks. Gel 100 sks. cement

(If additional description is necessary, use BACK of this sheet)


Name of Plugging Contractor Voth Casing Pulling

STATE OF Kansas COUNTY OF Cowley, ss.  
Walter Voth (employee of owner) or (owner or operator) of the  
above-described well, being first duly sworn on oath, says: That I have knowledge of the  
facts, statements, and matters herein contained and the log of the above-described well as  
filed and that the same are true and correct. So help me God.

(Signature) Walter Voth  
715 South A Arkansas City Ks.  
(Address)

SUBSCRIBED AND SWORN TO before me this 13 day of Oct, 19 81

My Commission expires:

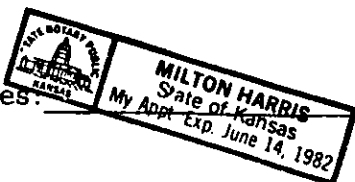

RECEIVED  
Notary Public  
STATE CORPORATION COMMISSION

10-15-81  
CONSERVATION DIVISION  
Wichita, Kansas

15-169-20104-00-00

**WELL COMPLETION REPORT AND DRILLER'S LOG**


API No. 15 169 20104  
 County Number

S. 33 T. 14 R. 2 E. W

Loc. C E/2 NW

County Saline

640 Acres  
N

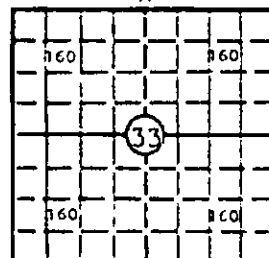

Elev.: Gr. 1277

DF 1280 KB 1282

Operator  
Range Oil Company, Inc.

Address  
240 Page Court, Wichita, Kansas 67202

Well No. 1 Lease Name Weller

Footage Location  
1320 feet from (N) ~~X~~ line 1980 feet from ~~X~~ (W) line NW/4

Principal Contractor Range Drlg. Co., Inc. Geologist Steve Kreidler

Spud Date 1-17-79 Date Completed MIRT 1-16-80 Total Depth 3290 P.B.T.D. 3280

Directional Deviation \_\_\_\_\_ Oil and/or Gas Purchaser \_\_\_\_\_

**CASING RECORD**

Report of all strings set — surface, intermediate, production, etc.

Purpose of string	Size hole drilled	Size casing set (in O.D.)	Weight lbs/ft.	Setting depth	Type cement	Sacks	Type and percent additives
Surface	10	85/8	Used	210	Common	170	2 % CaCl
Production	3290	7 7/8	New	3289	"	100	10% salt 2% gel 6 # gil/sx

**LINER RECORD**

**PERFORATION RECORD**

Top, ft.	Bottom, ft.	Sacks cement	Shots per ft.	Size & type	Depth interval
			1/2		3252-3257

**ACID, FRACTURE, SHOT, CEMENT SQUEEZE RECORD**

Amount and kind of material used	Depth interval treated
Acid 2000 gal 15%	3252-3257

RECEIVED  
STATE CORPORATION COMMISSION  
JUN - 9 1981

**INITIAL PRODUCTION**

Date of first production \_\_\_\_\_ Producing method (flowing, pumping, gas lift, etc.) \_\_\_\_\_

Swab CONSERVATION DIVISION  
Wichita, Kansas

RATE OF PRODUCTION PER 24 HOURS	Oil _____ bbls.	Gas _____ MCF	Water 25 _____ bbls.	Gas-oil ratio _____	CFPB _____
---------------------------------	-----------------	---------------	----------------------	---------------------	------------

Disposition of gas (vented, used on lease or sold) \_\_\_\_\_ Producing interval(s) \_\_\_\_\_

INSTRUCTIONS: As provided in KCC Rule 82-2-125, within 90 days after completion of a well, one completed copy of this Drillers Log shall be transmitted to the State Geological Survey of Kansas, 4150 Monroe Street, Wichita, Kansas 67209. Copies of this form are available from the Conservation Division, State Corporation Commission, 245 No. Water, Wichita, Kansas 67202. Phone AC 316-522-2206. If confidential custody is desired, please note Rule 82-2-125. Drillers Logs will be on an open file in the Oil and Gas Division, State Geological Survey of Kansas, Lawrence, Kansas 66044.

Operator ROCI		DESIGNATE TYPE OF COMP.: OIL, GAS, DRY HOLE, SWDW, ETC.: D&A
Well No. 1	Lease Name Weller	
S 33 T 14 R 2 E XX		

**WELL LOG**

Show all important zones of porosity and contents thereof; cored intervals, and all drill-stem tests, including depth interval tested, cushion used, time tool open, flowing and shut-in pressures, and recoveries.

SHOW GEOLOGICAL MARKERS, LOGS RUN, OR OTHER DESCRIPTIVE INFORMATION.

FORMATION DESCRIPTION, CONTENTS, ETC.	TOP	BOTTOM	NAME	DEPTH
---------------------------------------	-----	--------	------	-------

NE					
AD. SD.					
HD.					
SE					
TOP					
PK					
HO. SD.					
HO. LS.					
EA Heeb	1808	-524	1818	-534	
ST					
PE. LS.					
PE. SD.					
HOG					
Ex Lams.	2024	-740	2024	-740	12'
KC	2199	-915	2199	-915	5'
BKC	2375	-1091	2375	-1091	
CV.					
DS					
CK					
CT					
BV					
M	2662	-1378	2662	-1378	8'
SHt.	2911	-1627	2935	-1651	26'
SHt.	3063	-1779	3063	-1779	9'
Mq Sh	3167	-1883	3163	-1879	4'
Mq Sh	3249	-1965	3250	-1966	1'
Vol	3281	-1997	3280	-1996	4'

1-16-80 MIRT

1-17-80 Prep. to drill surf. hole.

1-18-80 8:15 am. Drlg. 430 U.S. 4:30 am. 1-18-B.  
1/4" @ 500 1/4" @ 1000

1-19-80 8:00 am Drlg. 1650 1/4" @ 1500

1-20-80 8:15 am Drlg. @ 2295

1-21-80 8:20 am Drlg. @ 2842 3/4" @ 1677  
2 1/2" @ 2500 ?

1-22-80 8:45 am Drlg. @ 3125 Est. Map sh 3163  
Est. Map dolo 3245

1-23-80 RTD 3290 (-2006) Rng. Great Guns

1-24-80 RTD 3290 (-2006) Raw 4 1/2" @ 3289  
w/ 100 SX. Plug down @ 6:30 pm. Plug held.

4 1/2" Csg. @ 3289 w/ 100 SX  
RTD 3290 (-2006) LTD 3290 (-2006)

USE ADDITIONAL SHEETS, IF NECESSARY, TO COMPLETE WELL RECORD.

Date Received	<p><i>Robert L. Brooks</i></p> <p>Signature</p> <p>V.P. Expl.</p> <p>Title</p> <p>9-4-90</p> <p>Date</p>
---------------	--