


Give All Information Completely  
Make Required Affidavit  
Mail or Deliver Report to:  
Conservation Division  
State Corporation Commission  
800 Bittling Building  
Wichita, Kansas

OR  
FORMATION PLUGGING RECORD Strike out upper line when reporting plugging off formations.

Saline County. Sec. 33 Twp. 14S Rge. 2 (E) (W)  
Location as "NE $\frac{1}{4}$ NW $\frac{1}{4}$ SW $\frac{1}{4}$ " or footage from lines SW of NE $\frac{1}{4}$   
Lease Owner W. K. PAGE  
Lease Name Joseph N. Lunden Well No. 1  
Office Address P.O. Box 777, Bristow, Oklahoma.  
Character of Well (completed as Oil, Gas or Dry Hole) Dry Hole  
Date well completed Feb. 18, 1947 19  
Application for plugging filed Feb. 18, 1947, with Ruel Durkee 19  
Application for plugging approved Feb. 18, 1947, by Ruel Durkee 19  
Plugging commenced Feb. 19, 1947 19  
Plugging completed Feb. 26, 1947 19  
Reason for abandonment of well or producing formation Dry

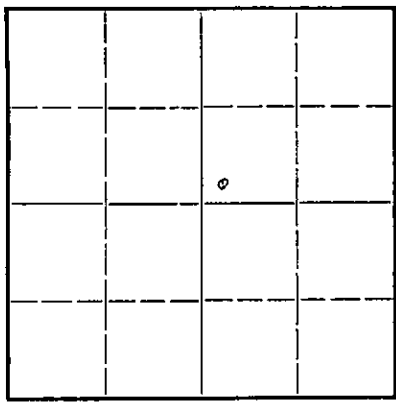

Locate well correctly on above Section Flat

If a producing well is abandoned, date of last production XX 19  
Was permission obtained from the Conservation Division or its agents before plugging was commenced? Yes

Name of Conservation Agent who supervised plugging of this well Ruel Durkee  
Producing formation Viola Lime Depth to top 3263 Bottom 3340 Total Depth of Well 3340 Feet  
Show depth and thickness of all water, oil and gas formations.

OIL, GAS OR WATER RECORDS

CASING RECORD

Formation	Content	From	To	Size	Put In	Pulled Out
Lime	Show oil-water	3263	3290	10-3/4	256	None
Lime	Dry	3290	3339	7 OD	3263	756
Lime	Water	3339	3340			

Describe in detail the manner in which the well was plugged, indicating where the mud fluid was placed and the method or methods used in introducing it into the hold. If cement or other plugs were used, state the character of same and depth placed, from \_\_\_\_\_ feet to \_\_\_\_\_ feet for each plug set.

Hole filled with heavy mud from 3340 to 800 ft.; casing was ripped off at 756, hole was then filled to top; casing was pulled, a 15-ft rock bridge was put in at 258' to 243', 25 sacks cement was then put on bridge, hole was filled to 5 feet of top with dirt, then five sacks cement were put in hole and allowed to run around top of surface pipe.

03-04-47

(If additional description is necessary, use BACK of this sheet)

Correspondence regarding this well should be addressed to W. K. PAGE  
Address P.O. BOX 777, BRISTOW, OKLA.

STATE OF OKLAHOMA, COUNTY OF CREEK, ss.  
L. L. Kemp (employee of owner) of the above-described well,  
being first duly sworn on oath, says: That I have knowledge of the facts, statements, and matters herein contained and the log of the above-described well as filed and that the same are true and correct. So help me God

(Signature) *L. L. Kemp*  
P.O. Box 777, Bristow, Okla. (Address)

SUBSCRIBED AND SWORN TO before me this 28th day of February 1947

My commission expires 12/27/49 Notary Public.

21-543-s 8-45-6M  
FILE 33 14 2w (OVER FOR LOG) 99 16

FORMATION

FROM	TO	FORMATION
0	100	shale
100	165	shale-shells
165	200	lime shells
200	265	shale & lime shells
265	350	shale-shells
350	690	lime shale
690	975	shale-shells
975	1275	shale lime
1275	1545	shale & shells
1545	1665	lime
1665	1830	broken lime
1830	2060	shale & lime
2060	2115	lime
2115	2145	soft lime
2145	2355	lime & shale
2355	2415	lime shale
2415	2465	lime
2465	2572	shale lime
2572	2670	shale
2670	2677	lime
2677	2730	hard shale lime
2730	2745	lime shale
2745	2810	lime & chert
2810	2850	hard lime chat
2850	2888	shale lime
2888	2998	shale
2998	3095	shale lime
3095	3170	lime
3170	3254	shale
3254	3267	coring      Core 3254-3270
3267	3278 $\frac{1}{2}$	lime soft
3278 $\frac{1}{2}$	3290	lime hard
3290	3302	lime white soft
3302	3307	lime light gray hard
3307	3329	lime hard gray
3329	3340	lime soft lite      -      water
	3340	T.D.