

15-169-00645-00-00

STATE OF KANSAS
STATE CORPORATION COMMISSION

WELL PLUGGING RECORD

Give All Information Completely
Make Required Affidavit
Mail or Deliver Report to:
Conservation Division
State Corporation Commission
800 Bitting Building
Wichita, Kansas

OR
FORMATION PLUGGING RECORD

Strike out upper line
when reporting plugging
off formations.

Saline County. Sec. 33 Twp. 14S Rge. 2W (E) (W)

Location as "NE 1/4 NW 1/4 SW 1/4" or footage from lines. Center NW NW

Lease Owner. Pearl B. Jackson

Lease Name. Craig Well No. 1

Office Address. 503 McBirney Bldg., Tulsa, Oklahoma

Character of Well (completed as Oil, Gas or Dry Hole) Dry hole

Date well completed. January 14 19.50

Application for plugging filed. January 16 19.50

Application for plugging approved. January 16 19.50


Plugging commenced. January 23 19.50

Plugging completed. January 30 19.50

Reason for abandonment of well or producing formation. Dry hole

If a producing well is abandoned, date of last production. 19.

Was permission obtained from the Conservation Division or its agents before plugging was commenced? Yes

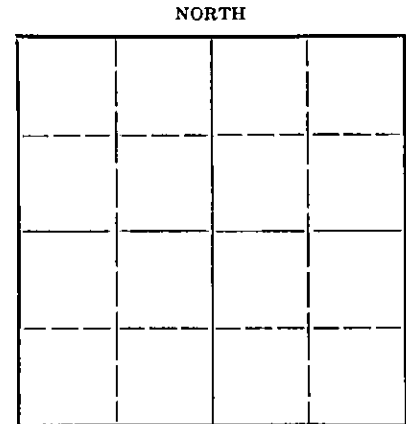

Locate well correctly on above
Section Flat

Name of Conservation Agent who supervised plugging of this well. Ruel Durkee

Producing formation. Upper Viola Depth to top. 3250 Bottom. 3268 Total Depth of Well. 3415 Feet

Show depth and thickness of all water, oil and gas formations.

OIL, GAS OR WATER RECORDS

CASING RECORD


Formation	Content	From	To	Size	Put In	Pulled Out
Upper Viola	Dry	3250	3268	8 5/8	281	none
				5 1/2	3250	2507

Describe in detail the manner in which the well was plugged, indicating where the mud fluid was placed and the method or methods used in introducing it into the hole. If cement or other plugs were used, state the character of same and depth placed, from.....feet to.....feet for each plug set.

Plugged back with cement pumped in hole from 3415 to 3278. Put 6 sacks of cement at 3245'. Shot pipe off at 2507'. Pulled pipe and mudded hole to 250'. Put 5 sacks of cement at 250'. Finished mudding hole and put 5 sacks of cement at top of surface.

(If additional description is necessary, use BACK of this sheet)

Correspondence regarding this well should be addressed to. Pearl B. Jackson
Address. 503 McBirney Bldg., Tulsa, Oklahoma

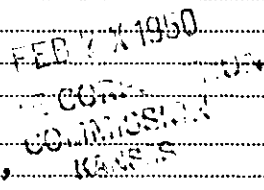

STATE OF Oklahoma, COUNTY OF Tulsa, ss.

L. B. Jackson, Jr. (employee of owner) or (owner or operator) of the above-described well, being first duly sworn on oath, says: That I have knowledge of the facts, statements, and matters herein contained and the log of the above-described well as filed and that the same are true and correct. So help me God.


(Signature) X *L. B. Jackson, Jr.*

503 McBirney Bldg., Tulsa, Oklahoma (Address)

SUBSCRIBED AND SWORN to before me this 3rd day of February, 19.50

Joe Christian
Notary Public.

My commission expires March 18, 1950

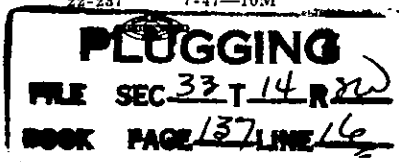

15-169-00645-00-00

ROTARY DRILLERS LOG

L. B. Jackson Company
Craig # 1

Total Depth 3415 K.B.. Est. Plugged
back depth with 43 sax of cement
thru drill pipe 3278 K.B.

C. NW $\frac{1}{4}$ of NW $\frac{1}{4}$
Sec. 33-14S-2W
Saline County, Kansas

K. B. 5.05 ft.-D.F. 2.75 ft. above
top ring on 8 5/8" x 5 1/2" Hinderliter
Suspension head in cellar.
Elevation - 1286' D.F.

Well spudded 12-16-49
(Shut down 40 hrs. for Xmas)
Completed 1-1-50

Casing Record-(8 5/8 cemented at 281 K.B. with
175 sax.
(5 1/2" cemented at 3250' K.B. with
150 sax.

Contractor: E.K. Carey, Contractor, (Rig #2) Box 620, McPherson, Kansas.

Figures Indicate Bottom of Formations KB

Soil and Shale	40	Lime and Shale	2533
Shale and Shells	205	Shale	2610
Lime	225	Shale and Lime	2662
Shale and Shells	245	Lime	2666
Lime	260	Lime and Shale	2726
Shale and Shells	280	Lime (Miss.)	2935
Lime	295	Shale	3070
Shale and Shells	310	Lime	3155
Lime and Shale	895	Lime and Shale	3209
Shale and Shells	1245	Shale and Lime	3247
Lime and Shale	1935	Shale	3248
Shale and Lime	2070	Lime (cored 3250-3261-2")	3415 TD KB.
Lime	2340		

Eleven new and one Rerun 7 7/8" bits, and 1-7" Reed KK Korehead were used on this hole.

The bottom of the 5 1/2" casing was placed by our Halliburton Lime measurement by being run on Drill pipe float before laying down, and on 5 1/2" casing float before cementing.

The above Drillers Rotary Log is complete and correct to the best of my knowledge.

E. K. CAREY, CONTRACTOR

Herbert Rhoton

By Herbert Rhoton

STATE OF KANSAS)
COUNTY OF MCPHERSON)

PLUGGING
FILE SEC-32-T-14-R-ow
BOOK PAGE 137 WELLS

FEB 2 X 1950

On this 5th day of January, 1950, before me, A. J. Darrah, a Notary Public, in and for said County and State, personally appeared Herbert Rhoton, to me personally known to be the identical person named in and who executed the foregoing instrument, and acknowledged that he executed and delivered the same as his free and voluntary act and deed, for the purpose and consideration therein set forth.

My Commission Expires MAY 6-1953

A. J. Darrah
Notary Public