

15-169-00644-00-00

WELL PLUGGING RECORD

Give All Information Completely  
Make Required Affidavit  
Mail or Deliver Report to:  
Conservation Division  
State Corporation Commission  
211 No. Broadway  
Wichita, Kansas

Saline County, Sec. 32 Twp. 14S Rge. (E) 2 (W)

Location as "NE/CNWxSWx" or footage from lines Center of NW/4 NE/4

Lease Owner Pearl B. Jackson

Lease Name Norton Well No. 4

Office Address Box 896 - Sapulpa, Oklahoma

Character of Well (completed as Oil, Gas or Dry Hole) dry hole

Date well completed 10-3 19 58

Application for plugging filed 11-15 19 58

Application for plugging approved 19


Plugging commenced 10-4 19 58

Plugging completed 10-4 19 58

Reason for abandonment of well or producing formation dry hole

If a producing well is abandoned, date of last production 19

Was permission obtained from the Conservation Division or its agents before plugging was commenced? yes

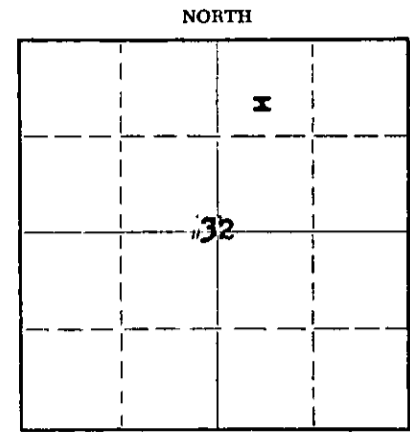

Locate well correctly on above Section Plat

Name of Conservation Agent who supervised plugging of this well Gib Toman, Holyrood, Kansas

Producing formation none Depth to top Bottom Total Depth of Well 3373 Feet

Show depth and thickness of all water, oil and gas formations.

OIL, GAS OR WATER RECORDS

CASING RECORD

FORMATION	CONTENT	FROM	TO	SIZE	PUT IN	PULLED OUT
Topeka lime		1593	1620	8 5/8	285	none
Kansas City - Lonsing		2068	2190			
Mississippi lime		2756	2978	cemented with 200 SACKS		
Hunton lime		3105	3207			
Maquoketa dolomite		3287	3320			

Describe in detail the manner in which the well was plugged, indicating where the mud fluid was placed and the method or methods used in introducing it into the hole. If cement or other plugs were used, state the character of same and depth placed, from feet to feet for each plug set.

Pits were jettied to make mud of heavy consistency, heavy mud circulated through drill pipe at bottom, half of drill pipe pulled and mud circulated again, 20 sack cement plug set at 200 feet through drill pipe, another 10 sack cement plug placed at 30 feet through drill pipe.

(If additional description is necessary, use BACK of this sheet)

Name of Plugging Contractor none

Address

STATE OF Oklahoma COUNTY OF Creek, ss.

George J. Turner (employee of owner) or (owner or operator) of the above-described

well, being first duly sworn on oath, says: That I have knowledge of the facts, statements, and matters herein contained and the log of the above-described well as filed and that the same are true and correct. So help me God.

(Signature) *George J. Turner*

P. O. Box 717 - Sapulpa, Okla. (Address)

SUBSCRIBED AND SWORN TO before me this 17th day of November, 19 58

*Howard E. Roney* Notary Public.

My commission expires 1-7-61

RECEIVED  
NOV 22 1958  
CONSERVATION DIVISION  
Wichita, Kansas

11-22-58

PLUGGING  
FILE SEC. 32 T. 14 R. 2W  
BOOK PAGE 142 LINE 30



