

15-169-00152-00-00

WELL PLUGGING RECORD

STATE OF KANSAS  
STATE CORPORATION COMMISSION

FORMATION PLUGGING RECORD

Strike out upper line when reporting plugging of formations.


Give All Information Completely  
Make Required Affidavit  
Mail or Deliver Report to:  
Conservation Division  
State Corporation Commission  
800 Bitting Building  
Wichita, Kansas

OR

Saline County, Sec. 31 Twp. 14S Rge. 2 (W)

Location as "NE 1/4 NW 1/4 SW 1/4" or footage from lines. NW 1/4 SW 1/4 SE 1/4  
Lease Owner Margay Oil Corporation  
Lease Name Z. C. Millikin Well No. 1  
Office Address 610 Oklahoma Building (P.O. Box 308) Tulsa, Oklahoma  
Character of Well (completed as Oil, Gas or Dry Hole) Dry hole  
Date well completed April 3rd 19 44  
Application for plugging filed April 3 19 44  
Application for plugging approved April 3 19 44  
Plugging commenced April 3 19 44  
Plugging completed April 3 19 44  
Reason for abandonment of well or producing formation Dry

NORTH

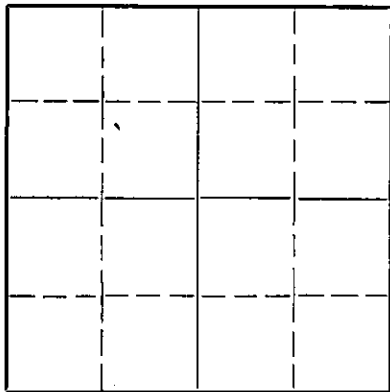

Locate well correctly on above Section Plat

If a producing well is abandoned, date of last production 19  
Was permission obtained from the Conservation Division or its agents before plugging was commenced? Yes

Name of Conservation Agent who supervised plugging of this well Durke  
Producing formation Depth to top Bottom Total Depth of Well 3310 Feet  
Show depth and thickness of all water, oil and gas formations.

OIL, GAS OR WATER RECORDS

CASING RECORD

Formation	Content	From	To	Size	Put In	Pulled Out
Surface	Sand & Shale & Anhydrite	0	255	8 5/8	255	Left in hole

Describe in detail the manner in which the well was plugged, indicating where the mud fluid was placed and the method or methods used in introducing it into the hold. If cement or other plugs were used, state the character of same and depth placed, from 10 feet to 250 feet for each plug set.

Hole was filled with heavy mud five feet up into the surface pipe, a wood plug placed on top of mud and 15 sacks cement placed on plug. Second wood plug placed 10 feet below surface and 5 sacks cement placed on top of this plug.

Mud was circulated through drill pipe, on bottom. As pipe was pulled, hole was circulated again at 1500 feet.

(If additional description is necessary, use BACK of this sheet)

Correspondence regarding this well should be addressed to Margay Oil Corporation  
Address P. O. Box 308, Tulsa 1, Oklahoma.

STATE OF Oklahoma COUNTY OF Tulsa, ss.

M. B. Spears, President

(employee of owner) or (owner or operator) of the above-described well, being first duly sworn on oath, says: That I have knowledge of the facts, statements, and matters herein contained and the log of the above-described well as filed and that the same are true and correct. So help me God.

(Signature) M. B. Spears

P. O. Box 308, Tulsa 1, Oklahoma  
(Address)

SUBSCRIBED AND SWORN TO before me this 15th day of April, 19 44

Mabel Edens

Notary Public.

My commission expires August 3, 1944



15-169-00152-00-00

Millikan #1  
NW/4 SW/4 SE/4 Section 31-14S-W  
Saline County, Kansas  
Margay Oil Corporation

Commenced: March 11, 1944  
 Completed: April 3, 1944

Sand	0	55
Shale and shells	55	180
Lime	180	210
Sand and gravel	210	240
Lime	240	251
Lime and shale	251	341
Sand	341	380
Sand and lime	380	415
Sandy lime	415	450
Lime and shale streaks	450	680
Shale and shells	680	740
Red bed	740	780
Sandy lime, shale streaks	780	840
Lime	840	920
Shale	920	955
Lime and shale	955	1085
Shale and shells	1085	1290
Shale and stks. lime	1290	1475
Lime and shale stks.	1475	1575
Lime and shale	1575	1602
Lime, shale streaks	1602	1675
Lime and shale	1675	1740
Lime and cherty lime	1740	1770
Lime and shale	1770	1785
Lime and shale stks.	1785	1805
Lime and shale	1805	2095
Lime	2095	2145
Lime and shale	2145	2185
Broken lime	2185	2260
Lime	2260	2330
Shale, lime	2330	2415
Shale	2415	2450
Shale and lime	2450	2485
Shale and lime stks.	2485	2530
Shale	2530	2580
Shale and lime	2580	2645
Miss. lime	2645	2691
Cherty lime	2691	2695
Miss. lime	2695	2725
Cherty lime	2725	2755
Lime	2755	2810
Cherty lime	2810	2860
Lime	2860	2880
Lime and shale	2880	2995
Shale	2995	3026
Shale and lime	3026	3040
Lime	3040	3070
Lime, soft	3070	3085
Lime and shale stks.	3085	3114
Cherty lime	3114	3155
Lime	3155	3159
Shale and lime	3159	3190
Shale	3190	3234
Viola lime	3234	3246
Lime	3246	3310

TOTAL DEPTH 3310  
 STATE OF OKLAHOMA )  
 COUNTY OF TULSA ) ss.

Casing Record:  
 8 5/8" casing set at 248' and cemented with  
 200 sacks cement

File 31 14-244  
 113-14

I hereby affirm that the above and foregoing is a true and correct copy of the log of your Millikan Well No. 1, located in the Northwest Quarter of the Southwest Quarter of the Southeast Quarter of Section 31, Township 14 South, Range 2 West, Saline County, Kansas.

HELMERICH & PAYNE, INC.

By [Signature]  
 Assistant Treasurer

Subscribed and sworn to before me, a Notary Public, this 7th day of April, 1944.  
 My commission expires October 18, 1947;

[Signature]  
 Notary Public