


15-169-20195-00-00

STATE OF KANSAS  
STATE CORPORATION COMMISSION

## WELL PLUGGING RECORD

Give All Information Completely  
Make Required Affidavit  
Mail or Deliver Report to  
Conservation Division  
State Corporation Comm.  
245 North Water  
Wichita, KS 67202

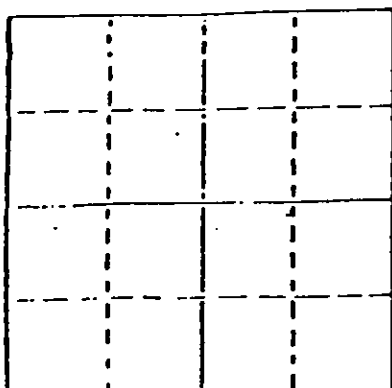

Locate well correctly on above  
Section Plat

Saline County, Sec. 31 Twp. 14S Rge. 2 <sup>X</sup>/<sub>W</sub>  
Location as "NE/CNW $\frac{1}{2}$ SW $\frac{1}{4}$ " or footage from lines  
1440' FSL 2140' FWL SW/4  
Lease Owner Range Oil Company, Inc.  
Lease Name Caywood Well No. 4  
Office Address 240 Page Court, 220 W. Douglas, Wichita, Kansas  
Character of Well (Completed as Oil, Gas or Dry Hole) Dry Hole

Date Well completed 11-29 1982  
Application for plugging filed 11-29 1982  
Application for plugging approved 11-29 1982  
Plugging commenced 11-29 1982  
Plugging completed 11-29 1982  
Reason for abandonment of well or producing formation

" Dry Hole  
If a producing well is abandoned, date of last production 19

Was permission obtained from the Conservation Division or  
its agents before plugging was commenced? Yes

Name of Conservation Agent who supervised plugging of this well Gilbert Toman  
Producing formation Depth to top Bottom Total Depth of Well 13320  
Show depth and thickness of all water, oil and gas formations.

## OIL, GAS OR WATER RECORDS

## CASING RECORD

FORMATION	CONTENT	FROM	TO	SIZE	PUT IN	PULLED OUT
				8-5/8	208	0

Describe in detail the manner in which the well was plugged, indicating where the mud fluid  
was placed and the method or methods used in introducing it into the hold. If cement or other  
plugs were used, state the character of same and depth placed, from feet to  
feet for each plug set.

Filled hole with mud, spotted 50 sx @ 300'  
Pushed plug to 40', spotted 10 sx  
10 sx in rat hole  
Sun Cementing Ticket #03672

(If additional description is necessary, use BACK of this sheet)


Name of Plugging Contractor Range Drilling Company, Inc.

STATE OF Kansas COUNTY OF Sedgwick ss.  
Gary L. Reed (employee of owner) or (owner or operator  
of the above-described well, being first duly sworn on oath, says: That I have knowledge of  
the facts, statements, and matters herein contained and the log of the above-described well  
is filed and that the same are true and correct. So help me God.

(Signature)

240 Page Court, 220 W. Douglas, Wichita, Kansas  
(Address)

SUBSCRIBED AND SWORN TO before me this 7<sup>th</sup> day of December, 1982

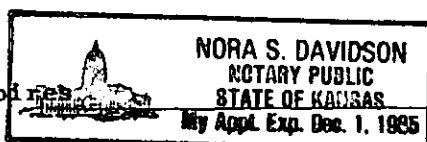

Notary Public.

2000  
12-02-82