


**STATE OF KANSAS
 STATE CORPORATION COMMISSION**

Give All Information Completely
 Make Required Affidavit
 Mail or Deliver Report to:
 Conservation Division
 State Corporation Commission
 800 Bitting Building
 Wichita, Kansas

OR
FORMATION PLUGGING RECORD

Strike out upper line
 when reporting plug-
 ging off formations.

NORTH

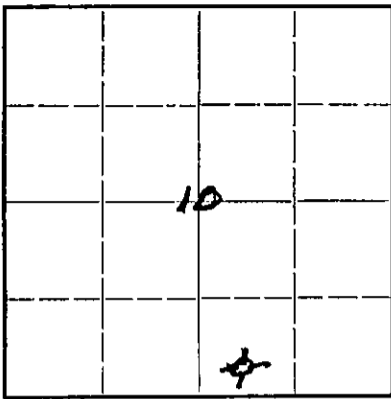

Locate well correctly on above
 Section Plat

Saline County. Sec. 10 Twp. 15 Rge. (E) 2 (W)
 Location as "NE 1/4 NW 1/4 SW 1/4" or footage from lines. C S/2 SW SE
 Lease Owner. Donald T. Ingling and Arthur L. Harper
 Lease Name. Reiff Well No. 2 Well No.
 Office Address. 708 Fourth National Bank Building
 Character of Well (completed as Oil, Gas or Dry Hole). Dry Hole
 Date well completed. February 25th 19 45
 Application for plugging filed. Verbally February 25th 19 45
 Application for plugging approved. Verbally February 25th 19 45
 Plugging commenced. February 25th 19 45
 Plugging completed. February 25th 19 45
 Reason for abandonment of well or producing formation. Dry Hole

If a producing well is abandoned, date of last production. 19
 Was permission obtained from the Conservation Division or its agents before plugging was com-
 menced? Yes

Name of Conservation Agent who supervised plugging of this well. Ruel Durkee
 Producing formation. Depth to top. Bottom. Total Depth of Well. 2868 Feet
 Show depth and thickness of all water, oil and gas formations.

OIL, GAS OR WATER RECORDS

CASING RECORD

Formation	Content	From	To	Size	Put In	Pulled Out
				8-5/8"	145 Ft.	None

Describe in detail the manner in which the well was plugged, indicating where the mud fluid was placed and the method or methods used in introducing it into the hold. If cement or other plugs were used, state the character of same and depth placed, from feet to feet for each plug set.

Filled hole with heavy mud, half way out gunned pits and circulated more heavy mud, wood plug at 145 ft., then 15 sacks heavy cement, then heavy mud, wood plug at 5 ft. and then 5 sacks heavy cement.

PLUGGING
 FILE 10 15-20
 200-5 NE-40

FEB 27 1945

(If additional description is necessary, use BACK of this sheet)

Correspondence regarding this well should be addressed to. Donald T. Ingling
 Address. 708 Fourth National Bank Building, Wichita 2, Kansas

STATE OF Kansas, COUNTY OF Sedgwick, ss.
 Donald T. Ingling (employee of owner) or (owner or operator) of the above-described well,
 being first duly sworn on oath, says: That I have knowledge of the facts, statements, and matters herein contained and the log of the above-described well as filed and that the same are true and correct. So help me God.

(Signature) Donald T. Ingling
 708 Fourth National Bank Bldg., Wichita, Kansas
 (Address)

SUBSCRIBED AND SWORN to before me this 26th day of February 19 45
 Leah V. Landrus
 Notary Public.

My commission expires April 10, 1948

15-169 - 00707 - 00-00

WELL LOG BRIEF NO. 2

DONALD T. INGLING, etal - Lease Owner Sec. 10, Twp. 15, Range 2W

DONALD T. INGLING - Contractor

Location: C 3/8 SW SE

Total Depth: 2868

County: Saline

Commenced: January 20, 1945

Elevation: 1374

Completed: February 25, 1945

Casings: 145' of 3-5/8"

Production: Dry Hole

Figures below indicate bottom of formation:

95	Shale & Shells
112	Shale
145	Lime Broken
240	Shale & Shells
670	Shale & Lime
755	Sandy Lime & Shale
825	Shale & Shale
915	Shale & Lime
1020	Shale & Shells
1045	Shale & Lime
1720	Broken Lime & Shale
1895	Broken Lime
2105	Lime
2187	Shale
2215	Lime K.C.
2270	Lime
2315	Lime & Shale
2520	Lime
2645	Lime & Shale
2815	Shale & Lime to 2825 which is the top of the Mississippi Lime
2868	<u>TOTAL DEPTH</u>

I hereby certify that this is a true and correct log of the above mentioned well.

DONALD T. INGLING

BY *Donald T. Ingling*

D. INGLING	
FILE	10 15 24
BOOK	5 40

STATE OF KANSAS) (ss
SEDGWICK COUNTY)

Subscribed and sworn to before me, a Notary Public in said County and State, this 25th day of February, 1945.

My Commission expires 4-19-48.

Leah V. Landrum
Notary Public