


STATE OF KANSAS
STATE CORPORATION COMMISSION

Give All Information Completely
Make Required Affidavit
Mail or Deliver Report to:
Conservation Division
State Corporation Commission
800 Bitting Building
Wichita, Kansas

OR
FORMATION PLUGGING RECORD

Strike out upper line
when reporting plug-
ging off formations.

NORTH

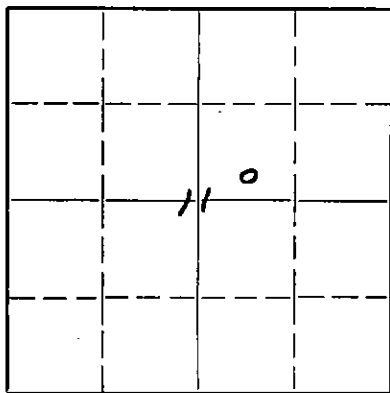

Locate well correctly on above
Section Plat

Saline County, Sec. 11 Twp. 15 Rgs. 2
Location as "NE $\frac{1}{4}$ NW $\frac{1}{4}$ SW $\frac{1}{4}$ " or footage from lines. C S/2 SW NE
Lease Owner Dale L. Morris
Lease Name Ritter Well No. 1
Office Address 230 Lulu, Wichita, Kansas
Character of Well (completed as Oil, Gas or Dry Hole) Dry Hole
Date well completed August 17 1944
Application for plugging filed August 18 1944
Application for plugging approved Verbally August 16 1944
Plugging commenced August 17 1944
Plugging completed August 17 1944
Reason for abandonment of well or producing formation Dry Hole

If a producing well is abandoned, date of last production None 19
Was permission obtained from the Conservation Division or its agents before plugging was com-
menced? Yes

Name of Conservation Agent who supervised plugging of this well Ruel Durkee
Producing formation None Depth to top Bottom Total Depth of Well 2790 Feet
Show depth and thickness of all water, oil and gas formations.


OIL, GAS OR WATER RECORDS

CASING RECORD

Formation	Content	From	To	Size	Put In	Pulled Out
				8-5/8"	160	None

Describe in detail the manner in which the well was plugged, indicating where the mud fluid was placed and the method or methods used in introducing it into the hold. If cement or other plugs were used, state the character of same and depth placed, from feet to feet for each plug set.

Circulated heavy mud at bottom of hole. Filled hole to bottom of surface pipe. Set plug at 160 feet with 20 sacks cement. Set top plug with 5 sacks cement.

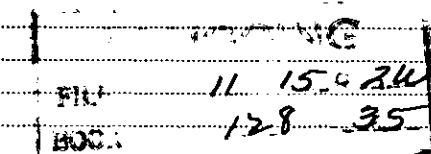

(If additional description is necessary, use BACK of this sheet)

Correspondence regarding this well should be addressed to Donald T. Ingling 08-19-1944
Address 708 Fourth National Bank Bldg., Wichita 2, Kansas

STATE OF Kansas COUNTY OF Sedgewick, ss.
W. W. Wright (employee of owner) or (owner or operator) of the above-described well,

being first duly sworn on oath, says: That I have knowledge of the facts, statements, and matters herein contained and the log of the above-described well as filed and that the same are true and correct. So help me God

(Signature) [Signature]
708 Fourth National Bank Bldg.
(Address)

SUBSCRIBED AND SWORN to before me this 18th day of August, 1944
Leah V. Landrum
Notary Public.

My commission expires April 10, 1948

15-169-00166-00-00

WELL LOG RITTER NO.

Dale L. Merris - Lease Owner

Sec. 11, Twp. 15S Range 2W

Donald T. Ingling - Contractor

Location: C 3/2 SW NE

Total Depth: 2790'

County: Saline (Kansas)

Commenced: August 1, 1944

Elevation: 1265'

Completed: August 17, 1944

Casing: 160' of 8-5/8"

Production: Dry Hole

Figures below indicate bottom of formation

120	Shale	2295	Lime & Shale
150	Shale	2318	Shale
160	Broken Lime	2335	Lime
380	Lime	2355	Lime & Shale
430	Lime & Shale Breaks	2430	Lime
575	Lime & Sand	2475	Lime & Shale
895	Broken Lime	2515	Lime
1170	Shale & Lime	2565	Shale - Shells
1400	Shale & Shells	2675	Lime & Shale
1490	Lime & Shale	2722	Shale
1620	Shale & Shells	2749	Mississippi Lime
1695	Lime & Shale	2790	<u>TOTAL DEPTH</u>
1955	Broken Lime		
2025	Shale Shells		
2150	Lime & Shale		
2180	Lime		

I hereby certify that this is a true and correct log of the above mentioned well.

DONALD T. INGLING

By *Donald T. Ingling*

STATE OF KANSAS)
COUNTY OF SENECA) ss.

Subscribed and sworn to before me, a Notary Public in said County and State, this 18th day of August, 1944.

Leah V. Landrus
Notary Public

My Commission expires: 4/10/48.

PLUGGING
FILE 11-15-R2-16
BOOK PAGE 128 LINE 35

08-19-1944