

15-169-20011-00-00

STATE OF KANSAS
STATE CORPORATION COMMISSION

Form CP-4

Give All Information Completely
Make Required Affidavit
Mail or Deliver Report to:
Conservation Division
State Corporation Commission
212 No. Market
Wichita, Kansas

WELL PLUGGING RECORD

Saline County, Sec. II Twp. 15 Rge. 2 (E) (W)
Location as "NE/CNWSW" or footage from lines SW/4 SE/4 SW/4

Lease Owner George Hess

Lease Name Agnes Johnson Well No. I

Office Address 505 North Charles, McPherson, Kansas 67460

Character of Well (completed as Oil, Gas or Dry Hole) oil

Date well completed 10-1 1967

Application for plugging filed 9-18 1969

Application for plugging approved 9-28 1969


Plugging commenced 9-18 1969

Plugging completed 9-20 1969

Reason for abandonment of well or producing formation

If a producing well is abandoned, date of last production 19

Was permission obtained from the Conservation Division or its agents before plugging was commenced? Yes

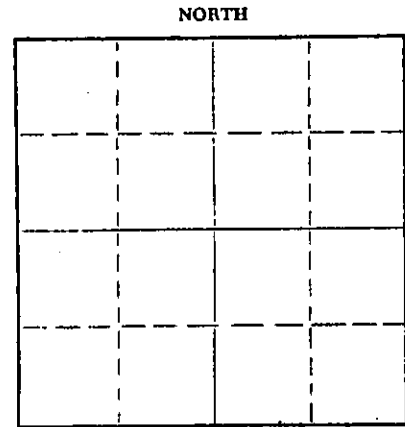

Locate well correctly on above Section Plat

Name of Conservation Agent who supervised plugging of this well Gilbert Teann

Producing formation Depth to top Bottom Total Depth of Well 2830' Feet

Show depth and thickness of all water, oil and gas formations.

OIL, GAS OR WATER RECORDS

CASING RECORD

FORMATION	CONTENT	FROM	TO	SIZE	PUT IN	PULLED OUT
				5 1/2"		2,543'

Describe in detail the manner in which the well was plugged, indicating where the mud fluid was placed and the method or methods used in introducing it into the hole. If cement or other plugs were used, state the character of same and depth placed, from feet to feet for each plug set.

Plugged off bottom of hole with sand. Sand from 2830' to 2800'. Dumped 5 sx of cement. Mudded hole to 125'. Made 10' of rack bridge. Dumped 25 sx of cement. Mudded hole to 40'. Made 10' of rack bridge. Dumped 10 sx of cement, filling to the bottom of the cellar.

RECEIVED
STATE CORPORATION COMMISSION
SEP 22 1969
CONSERVATION DIVISION
Wichita, Kansas
09-22-1969

(If additional description is necessary, use BACK of this sheet)

Name of Plugging Contractor Art Lamb Casing Pulling Co.

Address 2809 King St. Hutchinson, Kansas 67501

STATE OF Kansas, COUNTY OF Reno, ss.
Art Lamb (employee of owner) or (owner or operator) of the above-described well, being first duly sworn on oath, says: That I have knowledge of the facts, statements, and matters herein contained and the log of the above-described well as filed and that the same are true and correct. So help me God.

(Signature) Art Lamb


2809 King St. Hutchinson, Kansas 67501 (Address)

SUBSCRIBED AND SWORN TO before me this 20th day of September, 1969

Judy Lamb Notary Public.

My commission expires January 5, 1970

15-169-20011-00-00

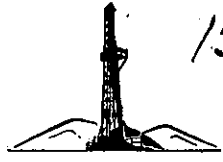

Blackstone Drilling, Inc.

Box 455 • 523 West Kansas • Phone CH 1-1250

McPHERSON • KANSAS
67460

October 19, 1967

COMPANY: GEORGE R. HESS & LARRY MOORE RANCH, INC.
 CONTRACTOR: BLACKSTONE DRILLING, INC.
 FARM: AGNES JOHNSON # 1
 LOCATION: SW/4 SE/4 SW/4, Sec. 11-15-2,
 Saline County, Kansas
 COMMENCED: October 14, 1967
 COMPLETED: October 19, 1967
 ELEVATION: 1360 K.B.

0	to	60	Shale & Shells
60	to	125	Lime
125	to	290	Shale & Lime
290	to	390	Lime & Shale
390	to	390	Lime
390	to	1760	Shale & Lime
1760	to	1950	Lime
1950	to	2169	Shale & Lime
2169	to	2530	Kansas City Lime
2530	to	2655	Lime & Shale
2655	to	2812	Shale & Lime
2812	to	2821	Mississippi
		2821	T. D.

RECEIVED
 STATE CORPORATIO. COMMISSION
 SEP 18 1967
 CONSERVATION DIVISION
 Wichita, Kansas
 09-18-1967

Cut 12 1/4 in. hole to 125 ft. and run 126 ft. of 8 5/8 in. O.D. casing and cemented on bottom at 125 ft. with 80 sacks cement. Plug down at 3:30 P.M., October 14, 1967.
 Cut 7 7/8 in. hole to 2821 ft. and run 2823 ft. of 5 1/2 in. Cemented with 85 sacks cement 7 feet off bottom at 2814 ft. Plug down at 1:00 A.M., October 18, 1967.


TOPS: Kansas City - 2169' Mississippi - 2812'

Measurements taken from K.B.

CERTIFICATE

I, H. J. Plouffe, President of Blackstone Drilling, Inc. do hereby certify that the above and foregoing is a true and correct copy of log on your Agnes Johnson #1, located on the SW/4 SE/4 SW/4 of Sec. 11-15-2, Saline County, Kansas as reflected by the Files of Blackstone Drilling, Inc.

H. J. Plouffe
 H. J. Plouffe, President

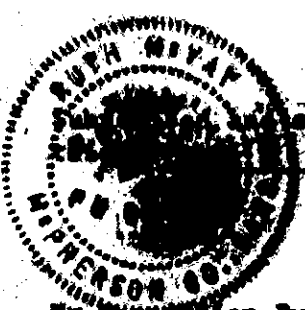

Sworn to before me a Notary Public in and for McPherson County, Kansas day of October, 1967.

Ruth McVay
 Ruth McVay - Notary Public

My Commission Expires: December 18, 1969.