


Give All Information Completely
Make Required Affidavit
Mail or Deliver Report to:
Conservation Division
State Corporation Commission
211 No. Broadway
Wichita, Kansas

WELL PLUGGING RECORD

Location as "NE/CNWxSWx" or footage from lines Saline County. Sec. 16 Twp. 15 Rge. 2W (E) (W)
C-NW-SE
Lease Owner Jayhawk Oil Company
Lease Name Cline Well No. 1
Office Address 412 One Twenty Building, Wichita, Kansas
Character of Well (completed as Oil, Gas or Dry Hole) Dry Hole
Date well completed 1-7-65 19
Application for plugging filed 1-7-65 19
Application for plugging approved 1-7-65 19
Plugging commenced 1-7-65 19
Plugging completed 1-7-65 19
Reason for abandonment of well or producing formation Dry Hole

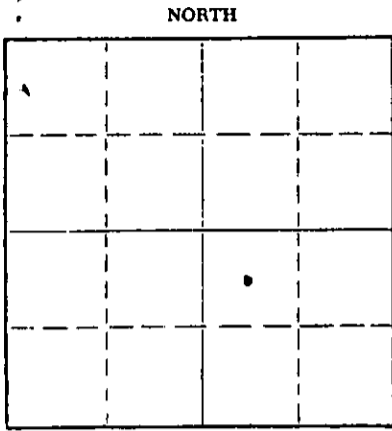

Locate well correctly on above Section Plat

If a producing well is abandoned, date of last production _____ 19____
Was permission obtained from the Conservation Division or its agents before plugging was commenced? Yes

Name of Conservation Agent who supervised plugging of this well Gilbert Toman
Producing formation _____ Depth to top _____ Bottom _____ Total Depth of Well 2795 Feet
Show depth and thickness of all water, oil and gas formations.

OIL, GAS OR WATER RECORDS

CASING RECORD

FORMATION	CONTENT	FROM	TO	SIZE	PUT IN	PULLED OUT

Describe in detail the manner in which the well was plugged, indicating where the mud fluid was placed and the method or methods used in introducing it into the hole. If cement or other plugs were used, state the character of same and depth placed, from 2795 feet to 170 feet for each plug set.

Mud from total depth to 170 ft., $\frac{1}{2}$ sk. hulls, plug and twenty sks. cement, Mud to 40 ft., $\frac{1}{2}$ sk. hulls, plug and ten sacks cement to botton of cellar

RECEIVED
STATE CORPORATION COMMISSION
JAN 11 1965
01-11-1965
CONSERVATION DIVISION
Wichita, Kansas

(If additional description is necessary, use BACK of this sheet)
Name of Plugging Contractor German Drilling Company
Address 502 Petroleum Building, Wichita, Kansas 67202

STATE OF Kansas, COUNTY OF Sedgwick, ss.
Harvey F. German (employee of owner) or (owner or operator) of the above-described well, being first duly sworn on oath, says: That I have knowledge of the facts, statements, and matters herein contained and the log of the above-described well as filed and that the same are true and correct. So help me God.

(Signature) Harvey F. German
Harvey F. German
502 Petroleum Building, Wichita, Kansas 67202
(Address)

SUBSCRIBED AND SWORN TO before me this 8th day of January, 19 65

Geneva M. German
Geneva M. German
Notary Public.

My commission expires February 28th, 1968.

15-11A-30004-00-00

21

WELL LOG--Cline #1

OPERATOR: Jayhawk Oil Company
412 One Twenty Building
Wichita, Kansas

LOCATION: c-nw-se
16-15-2w
Saline County
Kansas

CONTRACTOR: German Drilling Company
502 Petroleum Building
Wichita, Kansas 67202

Farm: Cline -- Well No. 1
Date Commenced: 2-2-65
Date Completed: 2-7-65 -- Rotary

<u>From</u>	<u>To</u>	<u>Formation</u>
0	10	Clay
10	170	Shale and lime
170	248	Shale and shells
248	405	Shale and shells
405	440	Red rock
440	775	Lime and shale
775	1382	Shale and lime
1382	1555	Shale and lime
1555	1772	Shale and lime
1772	2020	Lime and shale
2020	2133	Shale and lime
2133	2285	Lime and shale
2285	2540	Lime
2540	2725	Shale and lime
2725	2784	Shale and lime
2784	2795	Mississippi
2795		Total depth

RECEIVED
STATE CORPORATION COMMISSION

JAN 11 1965
01-11-FL05
CONSERVATION DIVISION
Wichita, Kansas

I hereby certify that the foregoing is a true and correct copy of the Well Log for the Cline #1, drilled for the Jayhawk Oil Company and completed January 7th, 1965.

GERMAN DRILLING COMPANY

Harvey F. German
Harvey F. German-Owner

STATE OF KANSAS)
) ss.
COUNTY OF SEDGWICK)

Subscribed and sworn to, before the undersigned a Notary Public, in and for the County and State aforesaid this eighth day of January, 1965.

Geneva M. German
Geneva M. German-Notary Public

My commission expires February 28th, 1968.