


WELL PLUGGING RECORD

Give All Information Completely
Make Required Affidavit
Mail or Deliver Report to:
Conservation Division
State Corporation Commission
212 No. Market
Wichita, Kansas

NORTH

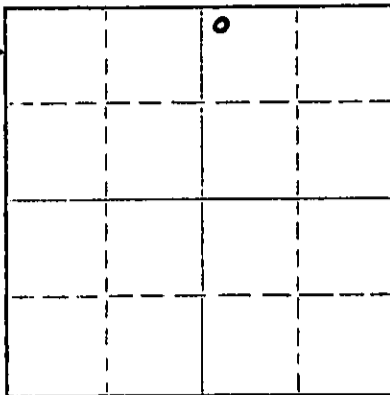

Locate well correctly on above
Section Plat

Saline County, Sec. 24 Twp. 15 Rge. (E) 2 (W)
Location as "NE/CNW&SW" or footage from lines NW NW NE
Lease Owner Melland Drilling Co., Inc.
Lease Name Melander Well No. 2
Office Address Box 783, McPherson, Kansas
Character of Well (completed as Oil, Gas or Dry Hole) dry hole
Date well completed 12/6 19 67
Application for plugging filed " 19 67
Application for plugging approved " 19 67
Plugging commenced " 19 67
Plugging completed " 19 67
Reason for abandonment of well or producing formation dry hole

If a producing well is abandoned, date of last production 19
Was permission obtained from the Conservation Division or its agents before plugging was commenced? yes

Name of Conservation Agent who supervised plugging of this well Gilbert Toman
Producing formation _____ Depth to top _____ Bottom _____ Total Depth of Well 2715 Feet
Show depth and thickness of all water, oil and gas formations.

OIL, GAS OR WATER RECORDS

CASING RECORD

FORMATION	CONTENT	FROM	TO	SIZE	PUT IN	PULLED OUT
				8 5/8"	115	none

Describe in detail the manner in which the well was plugged, indicating where the mud fluid was placed and the method or methods used in introducing it into the hole. If cement or other plugs were used, state the character of same and depth placed, from _____ feet to _____ feet for each plug set.

Filled hole with mud to 120', set plug at 120' and put 20sx of cement on plug, filled hole to 40', set plug at 40' and put 10sx of cement on plug. Put 2sx of cement in rat hole

REC 29 1967
12-29-1967

(If additional description is necessary, use BACK of this sheet)
Name of Plugging Contractor Melland Drilling Co, Inc.
Address same

STATE OF Kansas, COUNTY OF McPherson, ss.
Donald J. Melland (employee of owner) or (owner or operator) of the above-described well, being first duly sworn on oath, says: That I have knowledge of the facts, statements, and matters herein contained and the log of the above-described well as filed and that the same are true and correct. So help me God.

(Signature) Donald J. Melland
Box 783, McPherson, Kansas
(Address)

SUBSCRIBED AND SWORN TO before me this 18th day of December, 19 67

My commission expires Dec. 23, 1967
James B. Walker Notary Public.

15-169-20013-00-00

WELL RECORD

LEASE: Melander

WELL NO. 2

ELEVATION: 1270 RE est.

LOCATION: NW NW NE
Sec. 24-15-2W

COMMENCED: 11/20/67

COMPLETED: 12/16/67

OPERATOR: Melland Drilling Co., Inc.

CONTRACTOR: Melland Drilling Company, Inc
Post Office Box 783
McPherson, Kansas

CASING RECORD: 8 5/8" @ 115' / 85' ex

FORMATION	LOG	FORMATION	LOG
surface clay	40		
shale & shells	115		
anhydrite	245		
lime & shale	300		
shale & lime	1492		
lime & shale	2000		
shale & lime	2205		
lime & shale	2440		
shale & lime	2562		
lime & shale	2715		
RTD	2715		
Sample Tops			
Lansing	2053		
Mississippian	2564		

CERTIFICATE

State of Kansas, County of McPherson, ss.

I, Donald J. Melland, do hereby certify that the above is a true and correct copy of the log of the above named and described well, as reflected by the records of the Melland Drilling Company, Inc.

Donald J. Melland

Subscribed and sworn to before me, a Notary Public, in and for the County of McPherson, State of Kansas, this 12 day of December, 19 67.

My Commission expires: December 23, 1967

Notary Public