


STATE OF KANSAS  
STATE CORPORATION COMMISSION

WELL PLUGGING RECORD

Give All Information Completely  
Make Required Affidavit  
Mail or Deliver Report to:  
Conservation Division  
State Corporation Commission  
211 No. Broadway  
Wichita, Kansas

Saline County. Sec. 24 Twp. 15 Rge. 2W (E) (W)  
Location as "NE/CNWxSWx" or footage from lines CSW SE  
Lease Owner Melland Drilling Co.  
Lease Name Raetz Well No. I  
Office Address 1111 North Main Hutchinson, Kansas  
Character of Well (completed as Oil, Gas or Dry Hole) Dry Hole  
Date well completed 8-7 1963  
Application for plugging filed Sept 1963  
Application for plugging approved Sept 19 63  
Plugging commenced Sept 10 19 63  
Plugging completed Sept II 1963  
Reason for abandonment of well or producing formation Dry

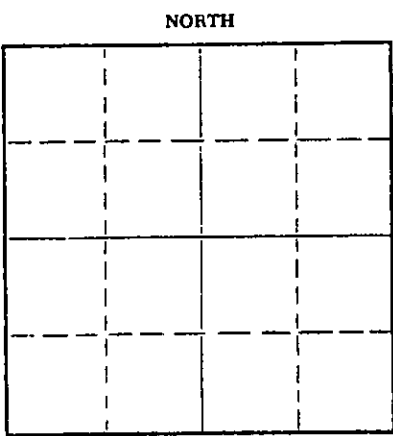

Locate well correctly on above  
Section Plat

If a producing well is abandoned, date of last production \_\_\_\_\_ 19\_\_\_\_  
Was permission obtained from the Conservation Division or its agents before plugging was commenced? Yes- Gilbert Toman

Name of Conservation Agent who supervised plugging of this well Gilbert Toman  
Producing formation \_\_\_\_\_ Depth to top \_\_\_\_\_ Bottom \_\_\_\_\_ Total Depth of Well 2759' Feet  
Show depth and thickness of all water, oil and gas formations.

OIL, GAS OR WATER RECORDS

CASING RECORD

FORMATION	CONTENT	FROM	TO	SIZE	PUT IN	PULLED OUT
				5 1/2"		2391'

Describe in detail the manner in which the well was plugged, indicating where the mud fluid was placed and the method or methods used in introducing it into the hole. If cement or other plugs were used, state the character of same and depth placed, from \_\_\_\_\_ feet to \_\_\_\_\_ feet for each plug set.

Plugged off bottom of hole with rock. Rock from 2759' to 2740'. Dumped 5 sx of cement. Mudded hole to 150'. Made 10' of rock bridge. Dumped 20 sx of cement. Mudded hole to 35'. Made 5' of rock bridge. Dumped 10' sx of cement, filling to the bottom of the cellar.

RECEIVED  
STATE CORPORATION COMMISSION  
SEP 23 1963  
09-23-1963  
CONSERVATION DIVISION  
Wichita, Kansas

(If additional description is necessary, use BACK of this sheet)  
Name of Plugging Contractor Art Lamb Casing Pulling Co.  
Address P.O. Box 983 Hutchinson, Kansas

STATE OF Kansas, COUNTY OF Reno, ss.  
Art Lamb (employee of owner) or (owner or operator) of the above-described well, being first duly sworn on oath, says: That I have knowledge of the facts, statements, and matters herein contained and the log of the above-described well as filed and that the same are true and correct. So help me God.

(Signature) Art Lamb  
2809 Kings Dr. Hutchinson, Kansas  
(Address)

SUBSCRIBED AND SWORN to before me this 20 th day of September 1963.

My commission expires January 5, 1966

Judy Lamb  
Notary Public.

WELL RECORD

15-169-00678-00-00

LEASE: Raetz

WELL NO. 1

LOCATION: CSW SE  
Sec. 24-15-2W

COMPLETED 8/2/63

COMPLETED 8/7/63  
(rotary)

OPERATOR: Melland Drilling Co., Inc. Elevation 1342 RB

CONTRACTOR: Melland Drilling Company, Inc.  
1111 North Main Street  
Hutchinson, Kansas

CASING RECORD: 8 5/8" @ 142'/105sx  
5 1/2" @ 2754'/50sx

FORMATION

LOG

Clay & Shale	142
Shale & Shells	225
Lime & Shale	996
Shale & Shells	1720
Lime & Shale	1902
Shale & Sand	2120
Lime & Shale	2653
Shale & Lime	2759
RTD	2759

Sample Tops

Lansing	2119
Mississippi	2750

RECEIVED  
STATE CORPORATION COMMISSION  
SEP 23 1963  
09-23-1963  
CONSERVATION DIVISION  
Wichita, Kansas


CERTIFICATE

I, Donald J. Melland, do hereby certify that the above is a true and correct copy of the log of the Raetz well No. 1, located CSW SE Sec. 24-15-2W, Saline County, Kansas, as reflected by the records of Melland Drilling Co., Inc.

  
Donald J. Melland

State of Kansas, County of McPherson, ss.

Subscribed and sworn to before me, a Notary Public, in and for McPherson County, Kansas, this 27th day of August, 1963

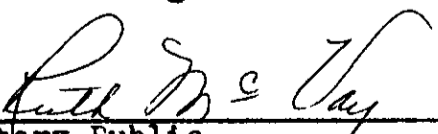  
Notary Public

My Commission Expires: 12-18-65