

15-169-00679-00-00

Give All Information Completely  
Make Required Affidavit  
Mail or Deliver Report to:  
Conservation Division  
State Corporation Commission  
211 No. Broadway  
Wichita, Kansas

WELL PLUGGING RECORD

Saline County, Sec. 24 Twp. 15 Rge. (E) 2W (W)

Location as "NE/CNW/SW" or footage from lines CSW NE

Lease Owner Melland Drilling Co., Inc.

Lease Name Raetz Well No. 2

Office Address Box 783, McPherson, Kansas

Character of Well (completed as Oil, Gas or Dry Hole) dry hole

Date well completed 8/16 19 64

Application for plugging filed 8/16 19 64

Application for plugging approved " 19 64


Plugging commenced " 19 64

Plugging completed " 19 64

Reason for abandonment of well or producing formation dry hole

If a producing well is abandoned, date of last production 19

Was permission obtained from the Conservation Division or its agents before plugging was commenced? yes

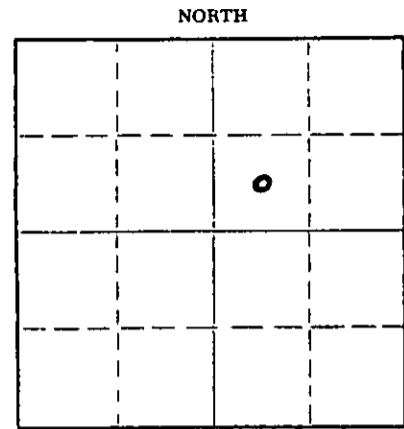

Locate well correctly on above  
Section Plat

Name of Conservation Agent who supervised plugging of this well Gilbert Toman

Producing formation Depth to top Bottom Total Depth of Well 2715 Feet

Show depth and thickness of all water, oil and gas formations.

OIL, GAS OR WATER RECORDS				CASING RECORD		
FORMATION	CONTENT	FROM	TO	SIZE	PUT IN	PULLED OUT
				8 5/8"		none

Describe in detail the manner in which the well was plugged, indicating where the mud fluid was placed and the method or methods used in introducing it into the hole. If cement or other plugs were used, state the character of same and depth placed, from feet to feet for each plug set.

heavy mud 2715' to 130'

wooden plug @ 130'

20sx cement on plug

heavy mud to 40'

10sx cement on plug

surface soil 6' to 0'

2sx cement in rat hole

RECEIVED  
STATE CORPORATION COMMISSION

AUG 21 1964  
08-21-1964  
CONSERVATION DIVISION  
Wichita, Kansas

(If additional description is necessary, use BACK of this sheet)

Name of Plugging Contractor same as above

Address " "

STATE OF Kansas, COUNTY OF McPherson

Donald J. Melland (employee of owner) or (owner) of the above-described

well, being first duly sworn on oath, says: That I have knowledge of the facts, statements, and matters herein contained and the log of the above-described well as filed and that the same are true and correct. So help me God.

(Signature) *Donald J. Melland*

Box 783, McPherson, Kansas (Address)

SUBSCRIBED AND SWORN to before me this 18th day of August, 19 64

*Louis S. Dulhal* Notary Public.

My commission expires December 23, 1967

15-16A-00679-00-00

# WELL RECORD

LEASE: Raetz

WELL NO. 2

ELEVATION: 1275 RB

LOCATION: CSW NE  
Sec. 24-15-2W

COMMENCED: 8/11/64

COMPLETED: 8/16/64

OPERATOR: Melland Drilling Co., Inc.

CONTRACTOR: Melland Drilling Company, Inc.  
Post Office Box 783  
McPherson, Kansas

CASING RECORD: 8 5/8" @ 135' / 85ex

FORMATION	LOG
shale & shells	135
lime & shale	465
lime	825
lime & shale	1219
shale & lime	1872
shale	2058
lime & shale	2475
shale & shells	2615
shale & lime	2703
RTD	2785

### Sample Tops

Lansing	2059
Mississippian	2697

DST #1 2698-2703, open 1 hr., weak blow through out, recovered 30' mud no shows of oil, BHP 742 & 582 FP 9 & 18/20 min.

FORMATION	LOG
-----------	-----

**RECEIVED**  
STATE CORPORATION COMMISSION

AUG 21 1964  
08-21-1984  
CONSERVATION DIVISION  
Wichita, Kansas

## CERTIFICATE

State of Kansas, County of McPherson, ss.

I, Donald J. Melland, do hereby certify that the above is a true and correct copy of the log of the above named and described well, as reflected by the records of the Melland Drilling Company, Inc.

*Donald J. Melland*

Subscribed and sworn to before me, a Notary Public, in and for the County of McPherson, State of Kansas,

this 18th day of August, 1964

*James A. Melland*  
Notary Public

My Commission expires: December 23, 1967