


15-169-00681-00-00

WELL PLUGGING RECORD

Give All Information Completely
Make Required Affidavit
Mail or Deliver Report to:
Conservation Division
State Corporation Commission
211 No. Broadway
Wichita, Kansas

NORTH

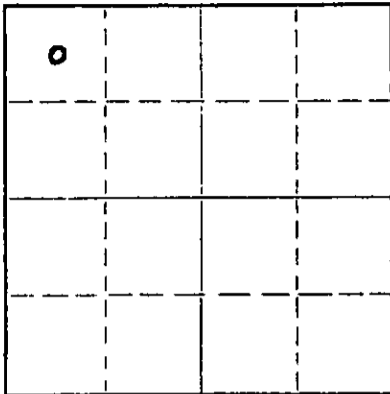

Locate well correctly on above
Section Plat

Saline County, Sec. 25 Twp. 15 Rge. (E) 2 (W)
Location as "NE/CNW/SW" or footage from lines CNW NW
Lease Owner Hollar Oil Co.
Lease Name Krauss "C" Well No. 1
Office Address 1117 Wichita Plaza, Wichita 2, Kansas
Character of Well (completed as Oil, Gas or Dry Hole) Dry Hole
Date well completed August 14, 19 63
Application for plugging filed August 14, 19 63
Application for plugging approved 19
Plugging commenced August 14, 19 63
Plugging completed August 14, 19 63
Reason for abandonment of well or producing formation Dry Hole

If a producing well is abandoned, date of last production 19
Was permission obtained from the Conservation Division or its agents before plugging was commenced? Yes

Name of Conservation Agent who supervised plugging of this well Cecil Jones
Producing formation none Depth to top Bottom Total Depth of Well 2771 Feet
Show depth and thickness of all water, oil and gas formations.

OIL, GAS OR WATER RECORDS

CASING RECORD

FORMATION	CONTENT	FROM	TO	SIZE	PUT IN	PULLED OUT
				8 5/8"	160'	none

Describe in detail the manner in which the well was plugged, indicating where the mud fluid was placed and the method or methods used in introducing it into the hole. If cement or other plugs were used, state the character of same and depth placed, from feet to feet for each plug set.

2771' to 160'	Heavy mud
160'	wood plug
160' to 30'	20 sacks cement
30'	wood plug
30' to 5'	8 sacks cement
5' to 0'	surface soil

RECEIVED
STATE CORPORATION COMMISSION

AUG 29 1963
08-29-1963
CONSERVATION DIVISION
WICHITA, KANSAS

(If additional description is necessary, use BACK of this sheet)

Name of Plugging Contractor Melland Drilling Co., Inc.
Address Box 783, McPherson, Kansas

STATE OF Kansas, COUNTY OF McPherson, ss.
Donald J. Melland (employee of owner) or (owner or operator) of the above-described well, being first duly sworn on oath, says: That I have knowledge of the facts, statements, and matters herein contained and the log of the above-described well as filed and that the same are true and correct. So help me God.

(Signature) Donald J. Melland
Box 783, McPherson, Kansas
(Address)

SUBSCRIBED AND SWORN TO before me this 27 th day of August, 19 63

My commission expires Dec. 18, 1965

Ruth M. Day
Notary Public.

WELL RECORD

15-1169-00681-00-00

LEASE: Krauss "C"

WELL NO. 1

LOCATION: CNW NW, Sec. 25-15-2W

COMMENCED: 8/8/63

COMPLETED: 8/14/63
(rotary)

OPERATOR: Hollar Oil Co.

CONTRACTOR: Melland Drilling Company, Inc.
1111 North Main Street
Hutchinson, Kansas

Dry & Abandoned

CASING RECORD: 8 5/8" x 1608/115ax

<u>FORMATION</u>	<u>LOG</u>
Shale & Shells	160
Shale & Shells	316
Lime & Shale	890
Shale & Shells	1925
Shale & Lime	2113
Shale	2120
Lime & Shale	2565
Shale & Shells	2771
RTD	2771

RECORDED
STATE OF KANSAS

AUG 29 1963
08-29-1963
COMMERCIAL RECORDS
HUTCHINSON, KANSAS

Sample Tops

Lansing 2120
Mississippi 2759


CERTIFICATE

I, Donald J. Melland, do hereby certify that the above is a true and correct copy of the log of the Krauss "C" well No. 1, located CNW NW Sec. 25-15-2W, Saline County, Kansas, as reflected by the records of Melland Drilling Co., Inc.


Donald J. Melland

STATE OF KANSAS, COUNTY OF McHERSON, SS.

Subscribed and sworn to before me, a Notary Public, in and for McPherson County, Kansas, this 27th day of August, 1963

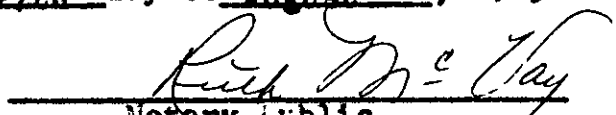
Notary Public

My Commission Expires; 12/18/65