


Give All Information Completely
Make Required Affidavit
Mail or Deliver Report to:
Conservation Division
State Corporation Commission
211 No. Broadway
Wichita, Kansas

WELL PLUGGING RECORD

Saline County. Sec. 25 Twp. 15 Rge. X (E) 2 (W)
Location as "NE/CNW&SW&" or footage from lines CNW NE
Lease Owner Lee Banks
Lease Name Olson Well No. 1
Office Address 725 Union Center, Wichita, Kansas
Character of Well (completed as Oil, Gas or Dry Hole) dry hole
Date well completed 6/24/64 19__
Application for plugging filed " 19__
Application for plugging approved " 19__
Plugging commenced " 19__
Plugging completed " 19__
Reason for abandonment of well or producing formation dry hole

NORTH

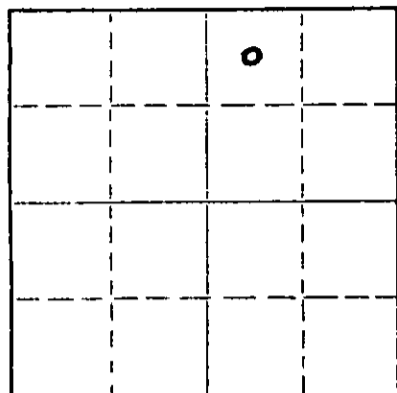

Locate well correctly on above
Section Plat

If a producing well is abandoned, date of last production _____ 19__
Was permission obtained from the Conservation Division or its agents before plugging was commenced? yes

Name of Conservation Agent who supervised plugging of this well B. Stafford
Producing formation _____ Depth to top _____ Bottom _____ Total Depth of Well 2777 Feet
Show depth and thickness of all water, oil and gas formations.

OIL, GAS OR WATER RECORDS

CASING RECORD

FORMATION	CONTENT	FROM	TO	SIZE	PUT IN	PULLED OUT
				8 5/8	138	none

Describe in detail the manner in which the well was plugged, indicating where the mud fluid was placed and the method or methods used in introducing it into the hole. If cement or other plugs were used, state the character of same and depth placed, from _____ feet to _____ feet for each plug set.

heavy mud	2777 to	140'
wooden bridge plug @		140'
25 sx cement	140' to	65'
heavy mud	65' to	35'
wooden bridge @		35'
15 sx cement	35' to	5'
surface soil	5' to	0'

RECEIVED
STATE CORPORATION COMMISSION
JUL 13 1964
07-13-1964
CONSERVATION DIVISION
Wichita, Kansas

Name of Plugging Contractor Melland Drilling co., Inc. (if additional description is necessary, use BACK of this sheet)
Address Box 783 McPherson, Kansas

STATE OF Kansas COUNTY OF McPherson, ss.
Donald J. Melland (employee of owner) or (owner or operator) of the above-described

well, being first duly sworn on oath, says: That I have knowledge of the facts, statements, and matters herein contained and the log of the above-described well as filed and that the same are true and correct. So help me God.

(Signature) Donald J. Melland
Box 783 McPherson, Kansas
(Address)

SUBSCRIBED AND SWORN TO before me this 29th day of June, 19 64

My commission expires December 23, 1967
Frank S. Melland Notary Public.

15-169-00680. 00-00

WELL RECORD

LEASE: Olson

WELL NO. 1

ELEVATION: 1350 RB

LOCATION: CNW NE
Sec. 25-15-2W

COMMENCED: 6/18/64

COMPLETED: 5/24/64

OPERATOR: Lee Banks

CONTRACTOR: Melland Drilling Company, Inc.
Post Office Box 783
McPherson, Kansas

CASING RECORD: 8 5/8" @ 138'/90sx

FORMATION	LOG
shale & shells	140
lime & shale	873
shale & shells	1675
lime & shale	2738
shale	2755
Mississippi	2777
RTD	2777
DST #1 2760-2777, open lhr. rec. 15' HOCWM, 120' OCMW, 245' SW. RHP 667 & 750 FP 69 & 181	
Sample Tops	
Lansing	2116
Mississippian	2755

FORMATION	LOG
-----------	-----

RECEIVED
STATE CORPORATION COMMISSION

JUL 13 1964
07-13-1964
CONSERVATION DIVISION
Wichita, Kansas

CERTIFICATE

State of Kansas, County of McPherson, ss.

I, Donald J. Melland, do hereby certify that the above is a true and correct copy of the log of the above named and described well, as reflected by the records of the Melland Drilling Company, Inc.

Donald J. Melland

Subscribed and sworn to before me, a Notary Public, in and for the County of McPherson, State of Kansas,

this 29th day of June, 19 64.

Frank D. [Signature]
Notary Public

My Commission expires: December 23, 1967