

15-169-00205-00-00


WELL PLUGGING RECORD

OR  
FORMATION PLUGGING RECORD

Strike out upper line when reporting plugging off formations.

STATE OF KANSAS  
STATE CORPORATION COMMISSION  
Give All Information Completely  
Make Required Affidavit  
Mail or Deliver Report to:  
Conservation Division  
State Corporation Commission  
800 Bittling Building  
Wichita, Kansas

Saline County, Sec. 30 Twp. 15S Rgc. ~~10~~ 2 (W)  
Location as "NE $\frac{1}{4}$ NW $\frac{1}{4}$ SW $\frac{1}{4}$ " or footage from lines NE $\frac{1}{4}$  SW $\frac{1}{4}$  SW $\frac{1}{4}$

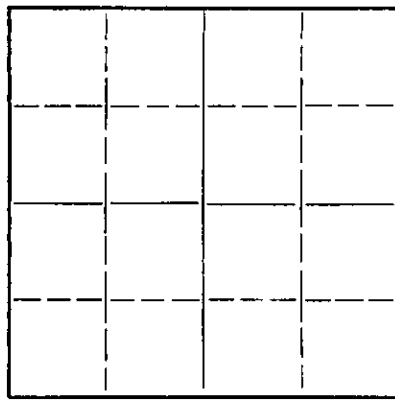

Locate well correctly on above Section Plat

Lease Owner R. L. Carnahan  
Lease Name Axel Johnson Well No. 1  
Office Address 628 N. Crestway, Wichita, Kansas  
Character of Well (completed as Oil, Gas or Dry Hole) Dry Hole  
Date well completed December 14, 19 42  
Application for plugging filed December 13, 19 42  
Application for plugging approved December 13, 19 42  
Plugging commenced December 13 19 42  
Plugging completed December 14 19 42  
Reason for abandonment of well or producing formation No shows

If a producing well is abandoned, date of last production 19.....  
Was permission obtained from the Conservation Division or its agents before plugging was commenced? Yes

Name of Conservation Agent who supervised plugging of this well Reuel Durkee  
Producing formation..... Depth to top..... Bottom..... Total Depth of Well 3605 Feet  
Show depth and thickness of all water, oil and gas formations.

OIL, GAS OR WATER RECORDS

CASING RECORD

Formation	Content	From	To	Size	Put In	Pulled Out
Well drilled with Rotary				10"	300'	none Cemented to top

Describe in detail the manner in which the well was plugged, indicating where the mud fluid was placed and the method or methods used in introducing it into the hold. If cement or other plugs were used, state the character of same and depth placed, from.....feet to.....feet for each plug set.

Filled hole with heavy mud with mud hog pump 3605 to 1800  
Set first plug @ 200' with 10 sacks cement  
Set second plug @ 25' with 5 sacks cement  
Filled hole with heavy mud between plugs and from 25' to surface

PLUGGING  
FILE SEC 30-T-15S-R-2-W  
BOOK PAGE 51-LINE 35

(If additional description is necessary, use BACK of this sheet)

Correspondence regarding this well should be addressed to.....  
Address.....

12-18-1942

STATE OF Kansas, COUNTY OF Sedgwick, ss.  
R. L. Carnahan, owner (employee of owner) or (owner or operator) of the above-described well,  
being first duly sworn on oath, says: That I have knowledge of the facts, statements, and matters herein contained and the log of the above-described well as filed and that the same are true and correct. So help me God.  
(Signature) R L Carnahan

SUBSCRIBED AND SWORN to before me this 17th day of December, 1942  
Virginia Lighty Notary Public.  
My commission expires March 3, 1945

