


Give All Information Completely
Make Required Affidavit
Mail or Deliver Report to:
Conservation Division
State Corporation Commission
211 No. Broadway
Wichita, Kansas

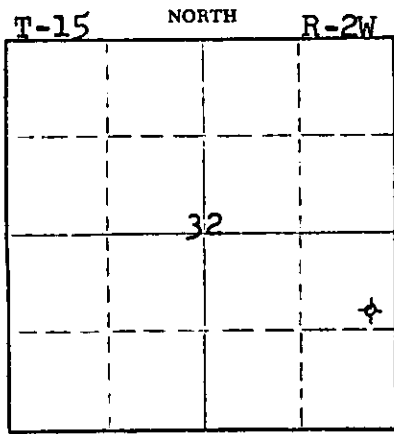

Locate well correctly on above Section Plat

Saline County, Sec. 32 Twp. 15 Rge. (E) 2 (W)
Location as "NE/CNWxSWx" or footage from lines C SE NE SE
Lease Owner N A Oil Survey
Lease Name McCormick Well No. 1
Office Address 1720 Pershing, Salina, Kansas
Character of Well (completed as Oil, Gas or Dry Hole) Dry Hole
Date well completed November 3, 1961
Application for plugging filed November 3, 1961
Application for plugging approved November 3, 1961
Plugging commenced November 4, 1961
Plugging completed November 4, 1961
Reason for abandonment of well or producing formation dry

If a producing well is abandoned, date of last production 19
Was permission obtained from the Conservation Division or its agents before plugging was commenced? Yes

Name of Conservation Agent who supervised plugging of this well Cecil Jones
Producing formation _____ Depth to top _____ Bottom _____ Total Depth of Well 3445 Feet
Show depth and thickness of all water, oil and gas formations.

OIL, GAS OR WATER RECORDS

CASING RECORD

FORMATION	CONTENT	FROM	TO	SIZE	PUT IN	PULLED OUT
				8 5/8"	235'	None

Describe in detail the manner in which the well was plugged, indicating where the mud fluid was placed and the method or methods used in introducing it into the hole. If cement or other plugs were used, state the character of same and depth placed, from _____ feet to _____ feet for each plug set.

Circulated heavy mud, set plug at 240 ft, 1/2 sack hulls and 20 sacks cement, set plug at 35 ft, 1/2 sack hulls and 8 sacks cement - 2 sacks cement in rathole.

11-08-1961

(If additional description is necessary, use BACK of this sheet)
Name of Plugging Contractor Donald T. Ingling
Address 615 First National Building, Wichita 2, Kansas

STATE OF KANSAS, COUNTY OF SEDGWICK, ss.
D. T. Ingling (employee of owner) or (owner or operator) of the above-described well, being first duly sworn on oath, says: That I have knowledge of the facts, statements, and matters herein contained and the log of the above-described well as filed and that the same are true and correct. So help me God.

(Signature) *D. T. Ingling*
615 First National Bldg., Wichita 2
(Address)

SUBSCRIBED AND SWORN TO before me this 7th day of November, 1961

My commission expires Feb. 27, 1964

Notary Public.

15-1691-00197-00-00
WELL LOG - McCORMICK NO. 1

N A Oil Survey, Lease Owner

Section 32-15-2W

Donald T. Ingling, Contractor

Location: C SE NE SE

Commenced: 10-24-61

County: Saline

Completed: 11-4-61

Production: Dry

Total Depth: 3445'

Elevation: 1295 RB

Casing: 8 5/8" 235' (160 sacks cement)

Figures below indicate bottom formation

40 surface clay
170 shale
235 lime and shale
400 lime and shells
640 lime and shells
980 lime and shale
1115 lime and shale
1220 shale and shells
1545 shale and shells
1730 shale and shells
1860 lime and shale
1960 lime and shale
2000 shale and lime
2115 shale and sand
2220 shale and lime
2340 lime
2440 lime
2510 lime
2610 lime
2740 shale and shells
2841 lime and shale
2905 Mississippi
2995 Mississippi
3059 lime - Mississippi
3115 shale
3190 shale
3270 shale and lime
3317 lime
3335 shale
3395 shale
3445 shale and lime
3445 Total Depth

11-03-1961

I certify this is a true and correct copy of the above mentioned well.

STATE OF KANSAS, COUNTY OF SEDGWICK: ss.

Subscribed and sworn to before me, a Notary Public, in said county and state.

W. T. Ingling
W. E. Black
Notary Public

My commission expires: Feb. 27, 1964