

15-169-30034-00-00


STATE OF KANSAS  
STATE CORPORATION COMMISSION

Give All Information Completely  
Make Required Affidavit  
Mail or Deliver Report to:  
Conservation Division  
State Corporation Commission  
211 No. Broadway  
Wichita, Kansas

WELL PLUGGING RECORD

Saline County, Sec. 34 Twp. 15S Rge. 2W ~~XEX~~ (W)  
Location as "NE/CNW&SW" or footage from lines SE SW NE  
Lease Owner D. R. Lauck Oil Company, Inc.  
Lease Name Coburn Well No. 1  
Office Address 301 S. Broadway, Wichita, Kansas  
Character of Well (completed as Oil, Gas or Dry Hole) Dry Hole  
Date well completed May 10, 19 66  
Application for plugging filed May 10, 19 66  
Application for plugging approved May 10, 19 66  
Plugging commenced May 10, 19 66  
Plugging completed May 10, 19 66  
Reason for abandonment of well or producing formation Dry Hole

NORTH

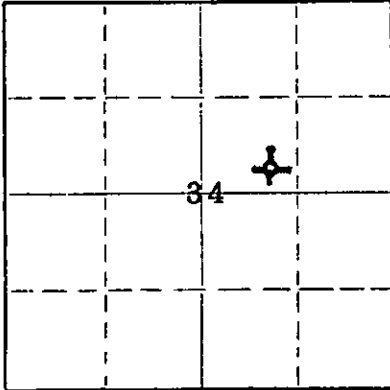

Locate well correctly on above  
Section Plat

If a producing well is abandoned, date of last production \_\_\_\_\_ 19\_\_\_\_  
Was permission obtained from the Conservation Division or its agents before plugging was commenced? Yes

Name of Conservation Agent who supervised plugging of this well Gilbert Toman  
Producing formation \_\_\_\_\_ Depth to top \_\_\_\_\_ Bottom \_\_\_\_\_ Total Depth of Well 3270 Feet  
Show depth and thickness of all water, oil and gas formations.

OIL, GAS OR WATER RECORDS

CASING RECORD

FORMATION	CONTENT	FROM	TO	SIZE	PUT IN	PULLED OUT
		0'	215'	8-5/8"	215'	None

Describe in detail the manner in which the well was plugged, indicating where the mud fluid was placed and the method or methods used in introducing it into the hole. If cement or other plugs were used, state the character of same and depth placed, from \_\_\_\_\_ feet to \_\_\_\_\_ feet for each plug set.

3270'-210' Mud  
210'-206' Plug  
206'-166' Cement, 25 sacks  
166'-40' Mud  
40'-36' Plug  
36'-6' Cement, 15 sacks  
(Bottom of Cellar)

RECEIVED  
STATE CORPORATION COMMISSION  
MAY 23 1966  
05-23-1966  
CONSERVATION DIVISION  
Wichita, Kansas

(If additional description is necessary, use BACK of this sheet)

Name of Plugging Contractor Sun Cementing Co.  
Address Great Bend, Kansas

STATE OF KANSAS COUNTY OF SEDGWICK ss.  
John H. Knightley (employee of owner) or (owner or operator) of the above-described well, being first duly sworn on oath, says: That I have knowledge of the facts, statements, and matters herein contained and the log of the above-described well as filed and that the same are true and correct. So help me God.

(Signature) John H. Knightley  
301 S. Broadway, Wichita, Kansas  
(Address)

SUBSCRIBED AND SWORN TO before me this 19th day of May, 19 66.

My commission expires March 12, 1967

Stella J. Lips Notary Public.

15-1109-30034-00-00

D. R. Lauck Oil Company, Inc.

Coburn #1

SE SW NE Sec. 34-15S-2W  
Saline County, Kansas

Commenced: May 3, 1966  
Completed: May 10, 1966

Casing Record: 215' 8-5/8" Cemented with 180 sacks Cement,  
4 sacks Calcium Chloride.

Elevation: GL 1372; DF 1375; KB 1377.

Drillers Log

Tops

Surface Clay	40
Shale & Shells	280
Anhydrite	290
Lime & Shale	390
Red Bed, Shale & Lime	545
Shale & Lime	835
Lime & Shale	1048
Shale & Lime	1300
Lime & Shale	2040
Shale & Lime	2245
Lime & Shale	2382
Shale & Lime	2710
Lime & Shale	2840
Miss. Lime	2942
Lime & Chert	3055
Chert	3060
Lime	3105
Lime & Shale	3220
Shale & Lime	3236
Hunton Lime	3270 RTD

	Samples
Lansing	2202 (-825)
Mississippian	2840 (-1463)
Kinderhook	3119 (-1742)
Hunton	3236 (-1859)
Rotary Total Depth	3270 (-1893)

DST #1 (H) 2988-3017, open 1 hour with strong blow declining to fair blow. Recovered 1937' water. ISIP 898#, 30 min. FSIP 898#, 30 min. IFP 774#. FFP 898#.

D&A

RECEIVED  
STATE COMMISSION  
MAY 23 1966  
05-23-1966  
CONSERVATION DIVISION  
Wichita, Kansas