FORM CP-4

15-169-20172-00-00

STATE OF KANSAS
STATE CORPORATION COMMISSION

WELL PLUGGING RECORD

Give All Information Completely
Make Required Affidavit
Mail or Deliver Report to
Conservation Division
State Corporation Comm.
245 North Water
Wichita, KS 67202

Saline County. Sec. 25 Twp. 16S Rge. 2 E/W
Location as "NE/CNW¼SW¼" or footage from lines
C E/2 NE
Lease Owner Gear Petroleum Company, Inc.
Lease Name Redden "A" Well No. 1-25
Office Address 300 Sutton Place Building, Wichita, Kansas
Character of Well (Completed as Oil, Gas or Dry Hole)
Dry Hole
Date Well completed 4-21 19 82
Application for plugging filed 4-21 19 82
Application for plugging approved 4-21 19 82
Plugging commenced 4-21 19 82
Plugging completed 4-21 19 82
Reason for abandonment of well or producing formation
Dry Hole
If a producing well is abandoned, date of last production
19
Was permission obtained from the Conservation Division or its agents before plugging was commenced? Yes

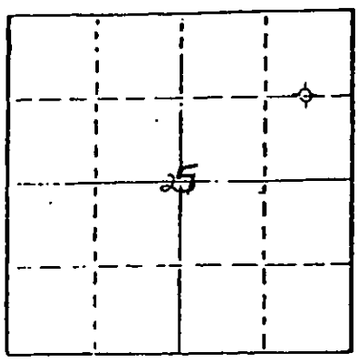

Locate well correctly on above Section Plat

Name of Conservation Agent who supervised plugging of this well Gilbert Toman
Producing formation Depth to top Bottom Total Depth of Well 2789
Show depth and thickness of all water, oil and gas formations.

OIL, GAS OR WATER RECORDS — CASING RECORD

FORMATION	CONTENT	FROM	TO	SIZE	PUT IN	PULLED OUT
				8-5/8	276	0

Describe in detail the manner in which the well was plugged, indicating where the mud fluid was placed and the method or methods used in introducing it into the hold. If cement or other plugs were used, state the character of same and depth placed, from feet to feet for each plug set.

Mud to 300', dry hole plug, spotted 50 sx cement
Mud to 40', 1/2 sx hulls, dry hole plug, spotted 10 sx cement
10 sx cement in rat hole

(If additional description is necessary, use BACK of this sheet)

Name of Plugging Contractor Range Drilling Company, Inc.

STATE OF Kansas COUNTY OF Sedgwick, ss.

Gary L. Reed (employee of owner) or (owner or operator) of the above-described well, being first duly sworn on oath, says: That I have knowledge of the facts, statements, and matters herein contained and the log of the above-described well is filed and that the same are true and correct. So help me God.

RECEIVED
STATE CORPORATION COMMISSION
MAY 07 1982
CONSERVATION DIVISION
Wichita, Kansas

(Signature) Gary L. Reed

240 Page Court, 220 W. Douglas, Wichita, Kansas
(Address)

SUBSCRIBED AND SWORN TO before me this 22nd day of April, 1982

Nora S. Davidson
Notary Public.

My commission expires

NORA S. DAVIDSON
NOTARY PUBLIC
STATE OF KANSAS
My Appt. Exp. Dec. 1, 1985

15-169-20172-00-00

WELL LOG

April 23, 1982

#1 Fast
N/2 NE/4 NE/4
SEC. 31-19S-23W
Ness County, Kansas

OPERATOR: Mid-Continent Energy Corporation
CONTRACTOR: Warrior Drilling Co.
COMMENCED: April 12, 1982
COMPLETED: April 21, 1982

8 5/8" @ 611' w/325 sx.

0	55	Surface Clay
55	335	Saad & Clay
335	613	Sand & Shale
613	990	Shale & Sand
990	1597	Anhydrite
1597	2730	Shale
2730	3335	Shale & Lime
3335	3945	Lime & Shale
3945	4256	Lime
4256	4377	Lime & Shale
4377	4397	RTD

RECEIVED
STATE CORPORATION COMMISSION
MAY 7 1982
CONSERVATION DIVISION
Wichita, Kansas
05-07-1982

4 1/2" @ 4404' w/150 sx.

We certify that the above and foregoing is a true and correct copy of the log on the #1 FAST located in Ness County, Kansas.

WARRIOR DRILLING CO.

F.W. Shelton, Jr., Vice President

Subscribed and sworn to before me this 26th day of April, 1982.

MARTHA E. GUSTIN
NOTARY PUBLIC
STATE OF KANSAS
MY APPT. EXPIRES 4-15-85

Martha E. Gustin Notary Public

15-169-20172-00-00

Well Log
Redden "A" #1-25
C E/2 NE
Section 25-16S-2W
Saline County, Kansas

Operator: Gear Petroleum Company, Inc.
300 Sutton Place Building
Wichita, Kansas 67202

Casing Record: 8-5/8" @ 276' w/200 sx cement

Date Completed: 4-21-82

From	To	
0	1265	Shale
1265	2300	Shale & lime
2300	2545	Lansing & KC
2545	2720	Shale & lime
2720	2789	Mississippi
2789		TD

State of Kansas
County of Sedgwick

Gary L. Reed, Vice President of Range Drilling Company, Inc., being first duly sworn on oath, says: That I have knowledge of the facts, statements, and matters herein contained and the log of the above-described well as filed and that the same are true and correct.

Gary L. Reed

SUBSCRIBED AND SWORN TO before me this 22nd day of April, 1982

Nora S. Davidson
Notary Public

My commission expires

NORA S. DAVIDSON
NOTARY PUBLIC
STATE OF KANSAS
My Appt. Exp. Dec. 1, 1985

RECEIVED
STATE CORPORATION COMMISSION
MAY - 7 1982
CONSERVATION DIVISION
Wichita, Kansas
05-07-1982

RELEASED
JUN 1 1983
FROM CONFIDENTIAL