


15-169-00239-00-00

WELL PLUGGING RECORD

Give All Information Completely
Make Required Affidavit
Mail or Deliver Report to:
Conservation Division
State Corporation Commission
211 No. Broadway
Wichita, Kansas

Saline County, Sec. 12 Twp. 16 Rge. (E) 2 (W)

Location as "NE/CNW&SW" or footage from lines _____
Lease Owner Melland Drilling Co., Inc.
Lease Name Burg Well No. 1
Office Address Box 783, McPherson, Kansas
Character of Well (completed as Oil, Gas or Dry Hole) dry hole
Date well completed 7/22/64 19____
Application for plugging filed 7/22/64 19____
Application for plugging approved " 19____
Plugging commenced " 19____
Plugging completed " 19____
Reason for abandonment of well or producing formation dry hole

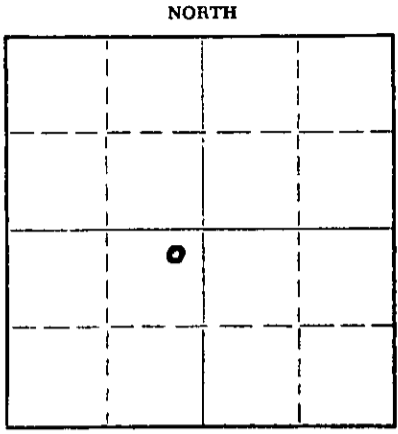

Locate well correctly on above
Section Plat

If a producing well is abandoned, date of last production _____ 19____
Was permission obtained from the Conservation Division or its agents before plugging was commenced? yes

Name of Conservation Agent who supervised plugging of this well Gilbert Toman
Producing formation _____ Depth to top _____ Bottom _____ Total Depth of Well 2781 Feet
Show depth and thickness of all water, oil and gas formations.

OIL, GAS OR WATER RECORDS

CASING RECORD

FORMATION	CONTENT	FROM	TO	SIZE	PUT IN	PULLED OUT
				8 5/8"	134	none

Describe in detail the manner in which the well was plugged, indicating where the mud fluid was placed and the method or methods used in introducing it into the hole. If cement or other plugs were used, state the character of same and depth placed, from _____ feet to _____ feet for each plug set.

heavy mud	2781' to 130'
wooden plug @	130'
20 sx cement	130' to 70'
WOODEN PLUG @	
heavy mud	70' to 40'
wooden plug @	40'
10 sx cement	40' to 5'
surface soil	5' to 0'

2 sx cement in rat hole

RECEIVED
STATE CORPORATION COMMISSION

JUL 28 1964
07 28 1964
CONSERVATION DIVISION
Wichita, Kansas

Name of Plugging Contractor Melland Drilling Co., Inc. (If additional description is necessary, use BACK of this sheet)
Address same as above

STATE OF Kansas COUNTY OF McPherson
Donald J. Melland (employee of owner) or XXXXXXXXXX (owner or operator) of the above-described

well, being first duly sworn on oath, says: That I have knowledge of the facts, statements, and matters herein contained and the log of the above-described well as filed and that the same are true and correct. So help me God.

(Signature) Donald J. Melland
Box 783, McPherson, Kansas
(Address)

SUBSCRIBED AND SWORN TO before me this 24th day of July, 1964

My commission expires December 23, 1967

Francis J. Tuller
Notary Public.

15-169-00239-00-00

WELL RECORD

LEASE: Burg

WELL NO. 1

ELEVATION: 1330 RB

LOCATION: NE NE SW
Sec. 12-16-2W

COMMENCED: 7/17/64

COMPLETED: 7/22/64

OPERATOR: Melland Drilling Co., Inc.

CONTRACTOR: Melland Drilling Company, Inc.
Post Office Box 783
McPherson, Kansas

CASING RECORD: 8 5/8" @ 134'/90sx

FORMATION	LOG
shale & shells	134
lime & shalo	1706
shale & shells	1915
lime & shale	2705
shale & shells	2744
Mississippi	2781
RTD	2781
Sample Tops	
Lansing	2105
Mississippian	2744

FORMATION	LOG
-----------	-----

RECEIVED
STATE CORPORATION COMMISSION

JUL 28 1964
07-28-1964
CONSERVATION DIVISION
Wichita, Kansas

CERTIFICATE

State of Kansas, County of McPherson, ss.

I, Donald J. Melland, do hereby certify that the above is a true and correct copy of the log of the above named and described well, as reflected by the records of the Melland Drilling Company, Inc.

Donald J. Melland

Subscribed and sworn to before me, a Notary Public, in and for the County of McPherson, State of Kansas,

this 24th day of July, 19 64

My Commission expires: December 23, 1967

Fred J. ...
Notary Public