


STATE OF KANSAS
STATE CORPORATION COMMISSION
200 Colorado Derby Bldg.
Wichita, Kansas 67202

Form CP-4
Rev. 12-15-80

WELL PLUGGING RECORD

Give All Information Completely
Make Required Affidavit

COUNTY Saline SEC. 13 TWP. 16 RGE. 2 E/W
Location as in quarters or footage from lines:
330' FSL & 1320' FEL

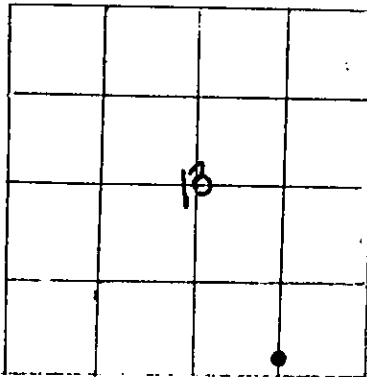

Locate Well
correctly on above
Section Platt.

Lease Owner R. J. Walker Oil Co.
Lease Name J. Weisgerber Well No. 1-13
Office Address 3524 N. W. 56th St. Oklahoma City, Okla. 73112
Character of Well (Completed as Oil, Gas or Dry Hole): Dry Hole
Date Well Completed 12-3-81
Application for plugging filed 12-3-81
Plugging commenced 12-3-81
Plugging completed 12-3-81

Reason for abandonment of well or producing formation

D & A

Was permission obtained from the Conservation Division or it's
Agent's before plugging was commenced? Yes

Name of Conservation Agent who supervised plugging of this well Merlin Unruh

Producing formation N/A Depth to top N/A bottom N/A T.D. 3532'

Show depth and thickness of all water, oil and gas formations.

OIL, GAS OR WATER RECORDS

Casing Record

Formation	Content	From	To	Size	Put in	Pulled Out
				8-5/8"	260'	0

Describe in detail the manner in which the well was plugged, indicating where the mud fluid was placed and the method or methods used in introducing it into the hold. If cement or other plugs were used, state the character of same and depth placed, from _____ feet to _____ feet for each plug set.

Fluid hells Plug @ 325'
Cement from 0 to 325'

(If additional description is necessary, use BACK of this sheet)

Name of Plugging Contractor Kansas Drilling & Well Service, Inc.

STATE OF Oklahoma COUNTY OF Oklahoma, ss.

Oscar N. Goode, Jr. (employee of owner) or ~~(owner or operator)~~ of the
above-described well, being first duly sworn on oath, says: That I have knowledge of the
facts, statements, and matters herein contained and the log of the above-described well as
filed and that the same are true and correct. So help me God.

(Signature) O. N. Goode, Jr.

3524 N.W. 56th St., #150, OKC, OK 73112
(Address)

SUBSCRIBED AND SWORN TO before me this 11th day of December, 19 81

Mary Kay Modrock

Notary Public.

My Commission expires: February 19, 1985

RECEIVED
STATE CORPORATION COMMISSION

DEC 12 1981
12-14-1981
CONSERVATION DIVISION
Wichita, Kansas