


STATE OF KANSAS
STATE CORPORATION COMMISSION

Give All Information Completely
Make Required Affidavit
Mail or Deliver Report to:
Conservation Division
State Corporation Commission
212 North Market, Insurance Bldg.
Wichita, Kansas

15-169-100687-00-00 Rec. 10-4-1960

WELL PLUGGING RECORD

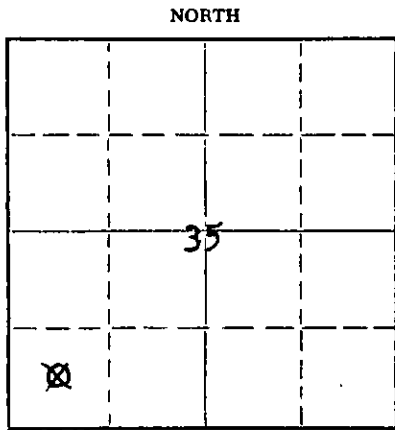

Locate well correctly on above Section Plat

Saline County. Sec. 35 Twp. 15S Rge. (E) 3 (W)
Location as "NE/CNW/SW" or footage from lines Center SW/4 SW/4
Lease Owner DeWeese & Sanderson
Lease Name Gunnerson "B" Well No. 1
Office Address Box 811, Salina, Kansas
Character of Well (completed as Oil, Gas or Dry Hole) Dry Hole
Date well completed September 24, 1960
Application for plugging filed September 25, 1960
Application for plugging approved 19
Plugging commenced September 25, 1960
Plugging completed September 25, 1960
Reason for abandonment of well or producing formation Dry Hole

If a producing well is abandoned, date of last production 19
Was permission obtained from the Conservation Division or its agents before plugging was commenced? Yes

Name of Conservation Agent who supervised plugging of this well Cecil Jones
Producing formation _____ Depth to top _____ Bottom _____ Total Depth of Well 3400 Feet
Show depth and thickness of all water, oil and gas formations.

OIL, GAS OR WATER RECORDS

CASING RECORD

FORMATION	CONTENT	FROM	TO	SIZE	PUT IN	PULLED OUT
				8-5/8"	301'	None

Describe in detail the manner in which the well was plugged, indicating where the mud fluid was placed and the method or methods used in introducing it into the hole. If cement or other plugs were used, state the character of same and depth placed, from _____ feet to _____ feet for each plug set.

3400' to 240' - Heavy mud
240' - Wood plug
240' to 180' - 15 sacks of cement
180' to 35' - Heavy mud
35' to 5' - 8 sacks of cement
5' to 0' - Surface soil

(If additional description is necessary, use BACK of this sheet)

Name of Plugging Contractor Melland Drilling Company, Inc.
Address 1111 North Main Street, Hutchinson, Kansas

STATE OF Saline COUNTY OF Kansas, ss.
T. W. Sanderson (~~employee of owner~~ or (~~owner~~ or operator) of the above-described well, being first duly sworn on oath, says: That I have knowledge of the facts, statements, and matters herein contained and the log of the above-described well as filed and that the same are true and correct. So help me God.

(Signature) T. W. Sanderson
P. O. Box 811, Salina, Kansas
(Address)

SUBSCRIBED AND SWORN to before me this 1st day of Sept, 1960

My commission expires Sept 24, 1964
B. J. Sanderson Notary Public.

W E L L R E C O R D

LEASE: Gunnerson "B"

WELL NO. 1

LOCATION: Center SW/4 SW/4
Section 35-15S-3W
Saline County, Kansas

COMMENCED: September 15, 1960

COMPLETED: September 24, 1960
(rotary)OPERATOR: DeWeese & Sanderson
Box 811
Salina, KansasCONTRACTOR: Melland Drilling Company, Inc.
1111 North Main Street
Hutchinson, Kansas

CASING RECORD: 8-5/8" OD casing set at 301' with 200 sacks of cement.

<u>FORMATION</u>	<u>LOG</u>
Surface soil, shale & Red Bed	100
Shale & shells	225
Shale, shells & gypsum	242
Anhydrite	365
Anhydrite, shale & lime	485
Lime & shale	920
Shale & lime	1225
Shale & shells	1650
Lime & shale	1950
Shale w/ some lime	2090
Shale	2225
Lime & shale	2475
Shale & lime	2595
Shale	2717
Shale	2780
Mississippi Lime	3035
Shale	3230
Shale with some lime	3298
Lime & shale	3370
Lime	3400

ROTARY TOTAL DEPTH

Flugged back from 3400' to 240' with heavy mud. Set plug at 240'. Plugged back from 240' to 180' with 15 sacks of cement. Plugged back from 180' to 35' with heavy mud. Set plug at 35'. Plugged back from 35' to 5' with 8 sacks of cement. Surface soil from 5' to 0'. Plugged and abandoned 4:00 a.m., 9/25/60.