

15-169-00732-00-00

STATE OF KANSAS
STATE CORPORATION COMMISSION

WELL PLUGGING RECORD

Give All Information Completely
Make Required Affidavit
Mail or Deliver Report to:
Conservation Division
State Corporation Commission
500 Blitting Building
Wichita, Kansas


OR

Strike out upper line
when reporting plugging
off formations.

FORMATION PLUGGING RECORD

Saline County. Sec. 35 Twp. 15 Rge. 3 (W)

Location as "NE $\frac{1}{4}$ NW $\frac{1}{4}$ SW $\frac{1}{4}$ " or footage from lines C SW of SW of SE
Lease Owner E. K. Carey, Contractor
Lease Name Bunger Well No. 1
Office Address McPherson, Kansas
Character of Well (completed as Oil, Gas or Dry Hole) Dry Hole
Date well completed June 19 19 50
Application for plugging filed same 19
Application for plugging approved same 19
Plugging commenced same 19
Plugging completed same 19
Reason for abandonment of well or producing formation dry

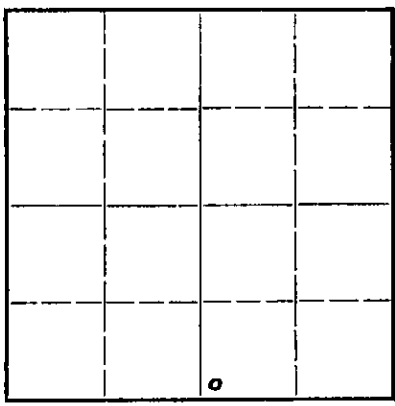

Locate well correctly on above
Section Flat

If a producing well is abandoned, date of last production 19
Was permission obtained from the Conservation Division or its agents before plugging was commenced? yes

Name of Conservation Agent who supervised plugging of this well
Producing formation dry Depth to top XX Bottom XX Total Depth of Well 3464 Feet
Show depth and thickness of all water, oil and gas formations.

OIL, GAS OR WATER RECORDS CASING RECORD

Formation	Content	From	To	Size	Put In	Pulled Out
				8 5/8	283	None

Describe in detail the manner in which the well was plugged, indicating where the mud fluid was placed and the method or methods used in introducing it into the hold. If cement or other plugs were used, state the character of same and depth placed, from... feet to... feet for each plug set.

Gunned pits and circulated on bottom, again half-way out of hole. Drove plug to 200' and filled in with rock to form bridge which held drill pipe. Mixed 15 sacks cement on this bridge. Filled hole to 20' below cellar floor with mud and pushed plug to here. Mixed 5 sacks cement and filled pipe to cellar floor. Plugging completed at 4 P.M.

06-22-1950

(If additional description is necessary, use BACK of this sheet)

Correspondence regarding this well should be addressed to E. K. Carey, Contractor
Address Box No. 620, McPherson, Kansas

STATE OF KANSAS, COUNTY OF MCPHERSON, ss.

Herbert Rhoton (employee of owner) or (owner or operator) of the above-described well, being first duly sworn on oath, says: That I have knowledge of the facts, statements, and matters herein contained and the log of the above-described well as filed and that the same are true and correct. So help me God.

(Signature) Herbert Rhoton

710 North Oak, McPherson, Kansas (Address)

SUBSCRIBED AND SWORN to before me this 20th day of June, 19 50

A. J. Larrick Notary Public.

My commission expires MAY 6 - 1953

