


Give All Information Completely
Make Required Affidavit
Mail or Deliver Report to:
Conservation Division
State Corporation Commission
212 North Market, Insurance Bldg.
Wichita, Kansas

WELL PLUGGING RECORD

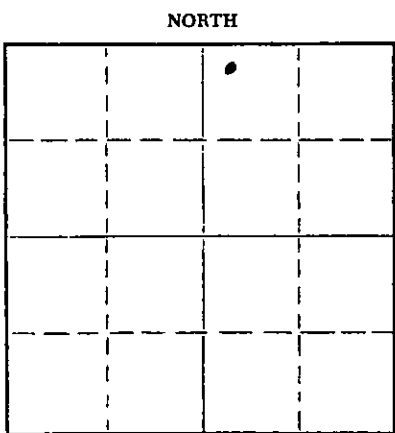

Saline County, Sec. 35 Twp. 15 Rge. 3 (X) (W)
Location as "NE/CNWxSWx" or footage from lines NW NW NE
Lease Owner Don McKellar
Lease Name Oetting Well No. 2
Office Address Salina, Kansas
Character of Well (completed as Oil, Gas or Dry Hole) Dry Hole
Date well completed 1 June 19 61
Application for plugging filed 1 June 19 61
Application for plugging approved 1 June 19 61
Plugging commenced 1 June 19 61
Plugging completed 1 June 19 61
Reason for abandonment of well or producing formation Dry Hole

If a producing well is abandoned, date of last production 19
Was permission obtained from the Conservation Division or its agents before plugging was commenced? Yes

Name of Conservation Agent who supervised plugging of this well Gilbert Toman
Producing formation _____ Depth to top _____ Bottom _____ Total Depth of Well 3383 Feet
Show depth and thickness of all water, oil and gas formations.

OIL, GAS OR WATER RECORDS

CASING RECORD

FORMATION	CONTENT	FROM	TO	SIZE	PUT IN	PULLED OUT

Describe in detail the manner in which the well was plugged, indicating where the mud fluid was placed and the method or methods used in introducing it into the hole. If cement or other plugs were used, state the character of same and depth placed, from _____ feet to _____ feet for each plug set.

Set Plug & hulls and 20 sacks cement at 240'. Filled up to 40' with heavy mud and set plug, hulls and 10 sks cement.

RECEIVED
STATE CORPORATION COMMISSION
JUL 5 1961
07-05-1961
CONSERVATION DIVISION
Wichita, Kansas

(If additional description is necessary, use BACK of this sheet)
Name of Plugging Contractor Duke Burt Drilling Co.
Address 1823 Washington, Great Bend, Kansas

STATE OF Kansas, COUNTY OF Barton, ss.
Duke G. Burt (owner or operator) of the above-described well, being first duly sworn on oath, says: That I have knowledge of the facts, statements, and matters herein contained and the log of the above-described well as filed and that the same are true and correct. So help me God.

(Signature) *Duke G. Burt*

(Address)

SUBSCRIBED AND SWORN TO before me this 14 day of June 19 61

My commission expires Aug. 26, 1961 *Jorda Small* Notary Public.



15-109-00217-00-00

R

DON McKELLAR
812 Hancock St.
Salina, Kansas

Well No. 2
Commenced RD: 5/22/61
Completed RD: 6/ 2/61
Total Depth: 3,383'
Casing: 255' of 8 5/8" 8 rd. thd.

Sec. NW NW NE 35-15-3W
Saline County, Kansas
Elevation:
Contractor: DUKE BURT
DRILLING CO.

Strata	Depth
Clay and Gyp	0- 40'
Shale & Shells	40- 200
Shale & Lime	200- 430
Lime (Ft. Riley)	430- 465
Lime & Shale (Streaks)	465-1010
Shale & Lime	1010-1655
Shale	1655-2142
Lime (Lansing)	2142-2180
Lime	2180-2475
Lime & Shale	2475-2560
Lime	2560-2720
Shale	2720-2791
Lime (Mississippian)	2791-2860
Lime, Shale & Chert	2860-2975
Lime & Shale streaks	2975-3020
Lime & Shale	3020-3321
Lime (Maquoketa Dolomite)	3321-3361
Lime (Viola)	3361-3383

I hereby certify that the above is a true and correct log of said well as reflected by the daily drilling report.

DUKE BURT DRILLING CO.

By *Duke Burt*

Signed and sworn to in my presence this 8 day of June, 1961.

Gona Small
Notary Public

My commission expires: August 26, 1961

RECEIVED
STATE CORPORATION COMMISSION
JUL 5 1961
07-05-1961
CONSERVATION DIVISION
Wichita, Kansas