

15-169-00452-00-00
WELL PLUGGING RECORD


STATE OF KANSAS
STATE CORPORATION COMMISSION

Give All Information Completely
Make Required Affidavit
Mail or Deliver Report to:
Conservation Division
State Corporation Commission
800 Bittling Building
Wichita, Kansas

OR
FORMATION PLUGGING RECORD

Strike out upper line
when reporting plugging
of formations.

NORTH

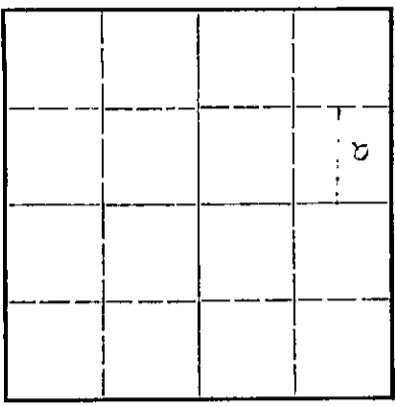

Locate well correctly on above
Section Flat

Saline County. Sec. 33 Twp. 15S Rge. 3 (E) (W)
Location as "NE 1/4 NW 1/4 SW 1/4" or footage from lines. C E 1/2 SE of NE
Lease Owner. Harry West, etal
Lease Name. Swick Well No. 1
Office Address. 108 South 12th Street, Salina, Kansas
Character of Well (completed as Oil, Gas or Dry Hole). dry hole
Date well completed. 7-23-1950
Application for plugging filed. 7-22-1950
Application for plugging approved. 7-22-1950
Plugging commenced. 11:00 p.m. 7-22-1950
Plugging completed. 7-23-1950
Reason for abandonment of well or producing formation. 260' SW in 15 min. on
Drill Stem test 3361 to 3365
If a producing well is abandoned, date of last production. none 19
Was permission obtained from the Conservation Division or its agents before plugging was commenced? yes

Name of Conservation Agent who supervised plugging of this well. Ruel Durkee
Producing formation. XX Depth to top. XX Bottom. XX Total Depth of Well. 3365 Feet K.B.
Show depth and thickness of all water, oil and gas formations.

OIL, GAS OR WATER RECORDS

CASING RECORD

Formation	Content	From	To	Size	Put In	Pulled Out
Viola Dolemite	Water	3361'	3365'	8 5/8"	312'	none

Describe in detail the manner in which the well was plugged, indicating where the mud fluid was placed and the method or methods used in introducing it into the hold. If cement or other plugs were used, state the character of same and depth placed, from.....feet to.....feet for each plug set.

Gunned pits and circulated heavy mud at 1/2 way out of hole.
Finished coming out with drill pipe. Filled hole from top to
200' level. Pushed wood plug to 200'. Threw in rack and hull
sacks to form solid bridge. Ran 15 sacks cement on top of this
bridge. Filled with mud to 25'. Bridged with wood plug, rock and
hulls sacks and ran 5 sacks of cement to cellar floor.

08-01-1950

(If additional description is necessary, use BACK of this sheet)

Correspondence regarding this well should be addressed to. Harry West
Address. 108 South 12th Street, Salina, Kansas

STATE OF Kansas, COUNTY OF Saline, ss.
Harry West (H. H. West) (employee of owner) or (owner or operator) of the above-described well,

being first duly sworn on oath, says: That I have knowledge of the facts, statements, and matters herein contained and the log of the above-described well as filed and that the same are true and correct. So help me God.

(Signature) [Handwritten Signature]

(Address)

SUBSCRIBED AND SWORN to before me this 29th day of July, 1950.
[Handwritten Signature] Notary Public.

My commission expires May 28th, 1951.

PLUGGING
FILE SEC 33 T 15 R 30
BOOK PAGE 19 LINE 2

ROTARY DRILLERS' LOG

15-169-00652-00-00

Harry West, etal
108 South 12th Street
Salina, Kansas

Total Rotary Depth 3365' K.B.
Elevation K.B. 1289.30'
" D.F. 1287'
" G.L. 1284.50'

Swick # 1

CASING RECORD

C E $\frac{1}{2}$ SE $\frac{1}{4}$ NE $\frac{1}{4}$
Sec. 33-15S-3W,
Saline County, Kansas

8 5/8" surface casing cemented at
312', using 225 sacks. Cement
circulated.

Well commenced: July 6, 1950
Well completed D. & A: July 23, 1950

No oil string run. DST 3361 to
3365. Recovered 260' salt water.
No oil showing. Tool open 15 min.

Contractor: E. K. Carey, Contractor (Rig #2) Box 620, McPherson, Kansas.
Geologist: Donald Hoy Smith, 5206 East Central, Wichita, Kansas.

Figures Indicate Bottom of Formation K.B.

Rotary Table, Base & Cellar	8	Lime and Shale	2705
Shale	90	Shale	2800
Shale and Shells	265	Lime and Shale	2822
Lime and Shale	840	Lime (Miss.)	3048
Lime	970	Shale and Lime	3180
Shale and Shells	1325	Shale	3216
Lime and Shale	1700	Lime	3250
Lime	1875	Shale	3298
Shale and Lime	2045	Lime	3365 TDKB.
Shale	2160		
Lime	2370		

Geologist Tops

Lansing - K.C.	2162 (-873)	Maquoketa Shale	3228 (-1939)
Base of K.C.	2524 (-1235)	" Dolemite	3295 (-2006)
Cherokee Shale	2662 (-1373)	Viola Crystalline	3351 (-2062)
Miss. Lime	2798 (-1509)	" Dolemite	3361 (-2072)
Kinderhook Shale	3056 (-1767)	Rotary T.D.	3365 (-2076)
Hunton	3214 (-1925)		

The above Rotary Driller's Log is complete and correct to the best of my knowledge.

PLUGGING
FILE SEC 33-15-3W
BOOK PAGE 10 LINE 2

E. K. CAREY, CONTRACTOR
Herbert Rhoton
By Herbert Rhoton, Supt.

STATE OF KANSAS) ss
COUNTY OF MCPHERSON)
On this 24th day of July, 1950, before me, A. J. Darrah,
a Notary Public, in and for said County and State, personally appeared
Herbert Rhoton, to me personally known to be the identical person named in
and who executed the foregoing instrument, and acknowledged that he executed
and delivered the same as his free and voluntary act and deed, for the
purpose and consideration therein set forth.

My Commission Expires: MAY 6-1953

A. J. Darrah
Notary Public