


Give All Information Completely  
Make Required Affidavit  
Mail or Deliver Report to:  
Conservation Division  
State Corporation Commission  
211 No. Broadway  
Wichita, Kansas

WELL PLUGGING RECORD

Saline County, Sec. 29 Twp. 15S Rge. 3 (E) 3 (W)

Location as "NE/CNW&SW4" or footage from lines Gen SW SE  
Lease Owner J. A. Davis - J. H. Child  
Lease Name Holmquist Well No. 1  
Office Address 121 West Second Street, Hutchinson, Kansas  
Character of Well (completed as Oil, Gas or Dry Hole) Oil  
Date well completed August 4, 1953 19  
Application for plugging filed April 13, 1957 19  
Application for plugging approved April 15, 1957 19  
Plugging commenced April 15, 1957 19  
Plugging completed April 18, 1957 19  
Reason for abandonment of well or producing formation oil depleted

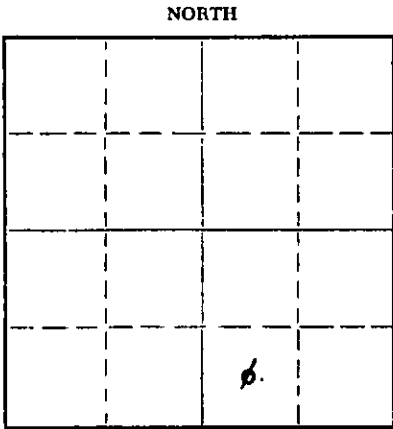

Locate well correctly on above Section Plat

If a producing well is abandoned, date of last production \_\_\_\_\_ 19\_\_\_\_  
Was permission obtained from the Conservation Division or its agents before plugging was commenced? Yes

Name of Conservation Agent who supervised plugging of this well Ruel Durkee  
Producing formation \_\_\_\_\_ Depth to top \_\_\_\_\_ Bottom \_\_\_\_\_ Total Depth of Well 3380 Feet  
Show depth and thickness of all water, oil and gas formations.

OIL, GAS OR WATER RECORDS

CASING RECORD

FORMATION	CONTENT	FROM	TO	SIZE	PUT IN	PULLED OUT
				5-1/2"	3377'	2823.64
				13-5/8"	115'	None

Describe in detail the manner in which the well was plugged, indicating where the mud fluid was placed and the method or methods used in introducing it into the hole. If cement or other plugs were used, state the character of same and depth placed, from \_\_\_\_\_ feet to \_\_\_\_\_ feet for each plug set.

Plug back with sand to 3370 feet and dump 6 sacks of cement. Pulled 5 1/2" casing.  
Filled hole with mud to 190 feet and set 5 foot rock bridge and dump 40 sacks of cement.  
Mudded hole to 20 feet and set 5' rock bridge and dump 10 sacks of cement to base of cellar.

(If additional description is necessary, use BACK of this sheet)

Name of Plugging Contractor Ace Pipe Pulling Company  
Address Great Bend, Kansas

STATE OF KANSAS, COUNTY OF SEDGWICK, ss.

(employee of owner) or (owner or operator) of the above-described well, being first duly sworn on oath, says: That I have knowledge of the facts, statements, and matters herein contained and the log of the above-described well as filed and that the same are true and correct. So help me God.

(Signature) J. A. Davis - J. H. Child  
J. H. Child (Address)

SUBSCRIBED AND SWORN TO before me this 25 day of April, 19 57

My commission expires 8/30/60

J. H. Child  
Notary Public.  
STATE CORPORATION COMMISSION

PLUGGING  
FILE SEC. 29, T. 15, R. 3W.  
BOOK PAGE 5, L.I.E. 38

APR 18 1957  
DIVISION

STERLING DRILLING COMPANY  
Sterling, Kansas

WELL LOG ----- HOLMQUIST #1

Location: SW SW SE Section 29, Township 15, Range 3 West, Saline  
County, Kansas

Owner: Sterling Drilling Company et al

Rotary Drilling Contractor: Sterling Drilling Company  
Cable Tools Contractor: KC Drilling Company

Commenced: July 15, 1953  
Complete: July 26, 1953 (w/r)  
August 4, 1953 (w/c/t.)

Total Depth: 3380' (w/r) and (C/t)

<u>Log</u>	<u>CASING RECORD</u>
0- 60 Surface Clay	115' of 13-5/8" Surface Pipe
60- 340 Shale and Shells	Cemented with 125 sacks cement.
340- 845 Lime	
845-2245 Lime and Shale	3389.14' of 5 1/2" Casing, set at
2245-2350 Lime	3377'. Cemented with 50 sacks
2350-2480 Lime and Shale	cement.
2480-2620 Lime	
2620-2705 Lime and Shale	<u>PRODUCER</u>
2705-2847 Shale	
2847-3125 Lime	
3125-3375 Shale	
3375-3380 Lime	

CABLE TOOLS RECORD: Rigged up cable tools. Swabbed out drilling mud. Drilled 29' of cement and shoe to T.D. of 3380' K.B. 8 Hour Fillup, 400' oil, no water. Swabbed hole down. Acidized down casing with 1,000 gallons of Dowell Acid. Left well over night. Swabbed well down and swabbed well at rate of 1 barrel oil per hour, pulling swab once every hour off bottom. Acidized down casing with 1,000 gallons Dowell Acid. Left well over night. Swabbed well down and swabbed at rate of 2 barrels of oil per hour. Left well over night. Found 1,000' of fluid in hole at 8 a.m. Bailed acid water off bottom. Moved out cable tools. Ran rods and tubing with pulling unit. Put on pump.

STATE COMMISSION  
APR 15 1957  
Wichita, Kansas

**PLUGGING**  
FILE SEC. 29 T. 15 R. 3W  
BOOK PAGE 5 LINE 38

15-169-00132-00-00

# Ace Pipe Pulling Co.

License No. 2

Telephone 3602

Box 304

GREAT BEND, KANSAS

## PLUGGING RECORD

Moved In 4-15-57

Completed 4-18-57

Company	J.A. Davis and J.H. Child			
Address	121 West 2nd. Hutchinson, Kansas			
Lease	Holmquist	Well No. 1	Cy. Saline	State Kansas
Legal Description	C-SW-SE	Sec. 29	Twp. 15	Rng. 3W
Total Depth	3380'	Size Pipe	5 1/2"	Weight 14#
Casing Cemented At	3377'	With	50	Sacks
Size Surface Pipe	13 5/8"			
Cemented At	115'	With	Circ.	Sacks
Other Strings	none			
Well Plugged Back To	no			
Top Perforations	none			
Plugging Orders	Plug back with sand to 3370' and dump 6 sx. cement. Pull 5 1/2 casing. Mud to 190' and set 5' rock bridge and dump 40 sx. cement. Mud to 20' and set 5' rock bridge and dump 10 sx. cement to base cellar.			

State Supervisor Mr. R.E. Durkee

Phone 645 McPherson, Kansas

Company Representative J.H. Child

Phone MoHawk 2-4421 Hutchinson, Kansas

STATE CORPORATION COMMISSION  
APR 22 1957  
Secretary

RECEIVED  
04-23-1957

15-169-00132-00-00

INVOICE

W. D. HOBERECHT

Acc Pipe Pulling Co.

No. 331

Post Office, Box 364 Telephone 3602  
GREAT BEND, KANSAS

Your Order No. \_\_\_\_\_

J.A. Davis and J.H. Child

Location C-SW-SE

121 West 2nd

Well No. 1 Farm Holquist

Hutchinson, Ks.

Cy Saline Sec. 20 Twp. 19 R. 3E

DATE	TICKET NO.	DESCRIPTION	PRICE	AMOUNT
		RIG TIME Twenty two (22) hours	\$ 7.00	\$154.00
		TOTAL PIPE RECOVERED 2823.64	.20	564.70
		SERVICE CHARGE		
		MATERIAL FURNISHED 6 sx. cement	1.40	8.40
		MISCELLANEOUS 1 shot	10.00	10.00
		TOTAL DEBITS		\$737.10
		Thank you		

DAILY REPORT

4-15-57	1375	Rigged up. Plug back with sand from 3380 to 3370' and dumped 6 sx. cement with dump bailer. Cleaned out collar and set in jacks. Pulled tension and had 18" at 100,000 lbs.	(7 hrs.)
4-16-57	1376	Loaded hole and made shots at 3100' 3005' 2908' and 2816'. Pipe started at 2:30. Pulled 20' joints.	(7 hrs.)
4-17-57	1377	Pulled rest of pipe. 89 joints total. Loaded jacks. Mudded to 190' and set 5' rock bridge to 185'. Mixed and dumped 40 sx. cement with dump bailer.	(4 hrs.)
4-18-57	1378	Mudded to 20' and set 10' rock bridge to 10'. Mixed and poured 10 sx. cement to base cellar. Dismantled unit.	(4 hrs.)

State supervisor: Mr. R.E. Durkee  
Ph. 654 Moperson, Ks.