


WELL PLUGGING RECORD

Give All Information Completely  
Make Required Affidavit  
Call or Deliver Report to:  
Conservation Division  
State Corporation Commission  
800 Bitting Building  
Wichita, Kansas

NORTH

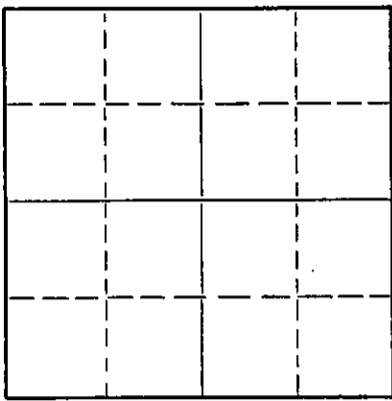

Locate well correctly on above Section Plat

Saline County. Sec. 27 Twp. 15 Rge. 3 (E) (W)  
Location as "NE/CNW $\frac{1}{4}$ /SW $\frac{1}{4}$ " or footage from lines SW SE E  
Lease Owner H. E. Peatling  
Lease Name Miller Well No. 41  
Office Address Box 447 Saline, Kansas  
Character of Well (completed as Oil, Gas or Dry Hole) Dry hole  
Date well completed 1-1 1952  
Application for plugging filed 1-1 1952  
Application for plugging approved 1-1 1952  
Plugging commenced 1-1 1952  
Plugging completed 1-1 1952  
Reason for abandonment of well or producing formation Dry hole

If a producing well is abandoned, date of last production..... 19.....  
Was permission obtained from the Conservation Division or its agents before plugging was commenced? Yes

Name of Conservation Agent who supervised plugging of this well Ruel E. Durkee  
Producing formation..... Depth to top..... Bottom..... Total Depth of Well 3540' Feet  
Show depth and thickness of all water, oil and gas formations.

OIL, GAS OR WATER RECORDS

CASING RECORD

Formation	Content	From	To	Size	Put In	Pulled Out
				8.5/8"	309.35	None

Describe in detail the manner in which the well was plugged, indicating where the mud fluid was placed and the method or methods used in introducing it into the hole. If cement or other plugs were used, state the character of same and depth placed, from..... feet to..... feet for each plug set.

Fill hole to 160' with heavy mud.  
Lade bridge @ 160' with 15 sacks cement.  
Lade bridge @ 20' with 5 sacks cement.

FEB 1952  
02-05-1952

(If additional description is necessary, use BACK of this sheet)  
Name of Plugging Contractor Penguin Petroleum, Inc.  
Address 709 Petroleum Building Wichita 2, Kansas

STATE OF KANSAS, COUNTY OF SALINE, ss. Donald J. Melland employee of a cert. (employee of owner or owner or operator) of the above-described well, being first duly sworn on oath, says: That I have knowledge of the facts, statements, and matters herein contained and the log of the above-described well as filed and that the same are true and correct. So help me God.

(Signature) W. B. Talbath  
709 Petroleum Bldg. Wichita, Kans  
(Address)

SUBSCRIBED AND SWORN TO before me this 5th day of February 1952.  
Edward S. Greider  
Notary Public.

My Commission Expires Jan. 31, 1953

HILL 27 T 15 R 30  
BOX 447 SALINE KS

15-1109-00096-00-00

Company: H. B. Peatlin  
Farm: Miller #1  
Comm: December 15, 1951  
Comp: January 1, 1952  
Contractor: Penguin Petroleum, Inc.

Sec. 27, T 15, R 3  
SW SE NE  
Saline County, Kansas  
Rotary Tools:  
Elevation: 1285' D.F.  
Rotary Total Depth: 3459'

Casing: 8 5/8" @ 309.35 Cem. w/250 sx.

0-40	Shale & sand
-250	Shale & shells
-320	Lime
-440	Lime & shale
-445	Shale & lime
-470	Shale
-500	Shale & lime
-525	Red bed
-885	Shale & lime
-915	Lime
-1015	Shale & lime
-1055	Sandy lime
-1650	Shale & lime
-1700	Lime
-1825	Shale & lime
-1925	Lime
-1955	Shale
-2200	Shale & lime
-2215	Lime
-2270	Sand
-2550	Shale & lime
-2565	Shale
-2800	Shale & lime
-2880	Lime
-2977	Lime ( little cherty)
-3060	Lime
-3075	Shale & lime
-3226	Shale
-3245	Lime
-3323	Shale
-3362	Maquoketa Dolomite
-3380	Viola
-3408	Lime & Dolomite
-3445	Lime
-3482	Sand & shale
-3510	Simpson shale
-3514	Shale
-3528	Simpson sand
-3536	Lime & sand
-3534	Shale & sand
-3549	Arbuckle lime

R.T.D. 3549'

Drill Stem Test #1 @ 3323' Recovery 2' slightly oily mud.

Tops:	Mississippi	2796'
	Kinderhook	3073'
	Hunton	3226'
	Maquoketa	3245'
	Viola	3362'
	Arbuckle	3534'

02-05-1952

Certified to be a true copy of the well log as indicated on daily drilling reports.

FILE 27 T 15 R 3  
BOOK PAGE 35 LINE 26

PENGUIN PETROLEUM, INC.

By Don Melland

Subscribed and sworn to before me, the undersigned, a Notary Public in and for Sedgwick County, Kansas, this \_\_\_ day of January, 1952.

My Commission Expires

Notary Public