


Give All Information Completely  
Make Required Affidavit  
Mail or Deliver Report to:  
Conservation Division  
State Corporation Commission  
211 No. Broadway  
Wichita, Kansas

NORTH

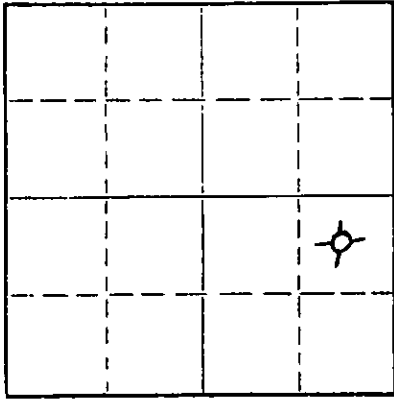

Locate well correctly on above Section Plat

Saline County. Sec. 26 Twp. 15 Rge. 3 (W)  
Location as "NE/CNW&SW&" or footage from lines C-NE SE  
Lease Owner Don McKellar Oil Explorations  
Lease Name Lindeman-Melch Well No. #1  
Office Address South Industrial Area, Ave. A, Salina, Kansas  
Character of Well (completed as Oil, Gas or Dry Hole) Dry Hole  
Date well completed August 16, 19 62  
Application for plugging filed August 16, 19 62  
Application for plugging approved 19  
Plugging commenced August 16, 19 62  
Plugging completed August 16, (12:30 P.M.) 19 62  
Reason for abandonment of well or producing formation Dry Hole

If a producing well is abandoned, date of last production 19  
Was permission obtained from the Conservation Division or its agents before plugging was commenced? Yes

Name of Conservation Agent who supervised plugging of this well Gilbert J. Toman  
Producing formation None Depth to top Bottom Total Depth of Well 3352 Feet  
Show depth and thickness of all water, oil and gas formations.

OIL, GAS OR WATER RECORDS

CASING RECORD

FORMATION	CONTENT	FROM	TO	SIZE	PUT IN	PULLED OUT
		0'	269'	8 5/8"	X	None

Describe in detail the manner in which the well was plugged, indicating where the mud fluid was placed and the method or methods used in introducing it into the hole. If cement or other plugs were used, state the character of same and depth placed, from feet to feet for each plug set.

First plug set at 265 ft. with 20 sacks cement through drill pipe, mudded up to 35 ft. from top. Plugged at 35 ft. with 10 sacks cement. 2 sacks cement in rathole.

08-24-62

(If additional description is necessary, use BACK of this sheet)

Name of Plugging Contractor Blackstone Drilling, Inc.  
Address Box # 455, McPherson, Kansas

STATE OF Kansas, COUNTY OF Kansas McPherson, ss.  
Operator (employee of owner or town or county operator) of the above-described well, being first duly sworn on oath, says: That I have knowledge of the facts, statements, and matters herein contained and the log of the above-described well as filed and that the same are true and correct. So help me God.

(Signature) Don McKellar  
Don McKellar, Ave. A, South Industrial Area, Salina, Kansas  
(Address)

SUBSCRIBED AND SWORN TO before me this 23rd day of August, 1962

My commission expires Sept 5, 1964  
Mystle D. Beeghly Notary Public.

15-169-00686 00-00



# Blackstone Drilling, Inc.

P. O. BOX 455 • PHONE CH 1-1250

McPHERSON • KANSAS

August 20, 1962

COMPANY: DOMINO KILLIAN OIL EXPLORATIONS  
 CONTRACTOR: BLACKSTONE DRILLING, INC.  
 FARM: LINDEMAN-WELCH # 1  
 LOCATION: C-NE SW, Sec. 26-15-3W,  
 Saline County, Kansas  
 COMMENCED: August 8, 1962  
 COMPLETED: August 16, 1962  
 ELEVATION: 1294 K.B.

0	to	35	Shale
35	to	40	Sand
40	to	245	Shale
245	to	269	Anhydrite Lime
269	to	670	Shale & Lime
670	to	885	Lime
885	to	1250	Shale & Shells
1250	to	1535	Shale
1535	to	2130	Shale & Lime
2130	to	2470	Lime
2470	to	2773	Shale & Lime
2773	to	2965	Mississippi Lime
2965	to	3010	Lime
3010	to	3173	Shale & Lime
3173	to	3258	Hunton Lime
3259	to	3340	Maquoketa Shale
3340	to	3345	Maquoketa Dolomite
3345	to	3352	Shale
		3352	T. D.

*Handwritten notes:*  
 18-24-1962

Cut 12 1/2 in. hole. Run 270.50 ft. of 8 5/8 in. surface pipe and cemented on bottom at 269 ft. with 165 sacks cement and 4 chloride. Cut 7 7/8 in. hole. Put first plug at 265 ft. with 20 sacks cement through drill pipe, mudded up to 35 ft. from top. Plugged at 35 ft. with 10 sacks cement. 2 sacks cement in rathole. Plugging completed at 12:30 P.M., August 16, 1962.

TCPS: Shly. Burgess - 2765'    Mississippi - 2773'    Hunton Lime - 3177'  
 Maquoketa Shale - 3258'    Maquoketa Dolomite - 3341

Measurements taken from K. B.

I, H. J. Flouffe, president of Blackstone Drilling, Inc., do hereby certify that the above and foregoing is a true and correct copy of log on the Lindeman-Welch # 1, located on Sec. 26-15-3W, Saline County, Kansas as reflected by the files of the Blackstone Drilling, Inc.

*Signature of H. J. Flouffe*  
 H. J. Flouffe, President

Subscribed and sworn to before me a Notary Public, within and for McPherson County, Kansas this 20<sup>th</sup> day of August 1962.

*Signature of Ruth McVay*  
 Ruth McVay - Notary Public

My Commission Expires: 12/18/65