


WELL PLUGGING RECORD

Give All Information Completely
Make Required Affidavit
Mail or Deliver Report to:
Conservation Division
State Corporation Commission
211 No. Broadway
Wichita, Kansas

NORTH

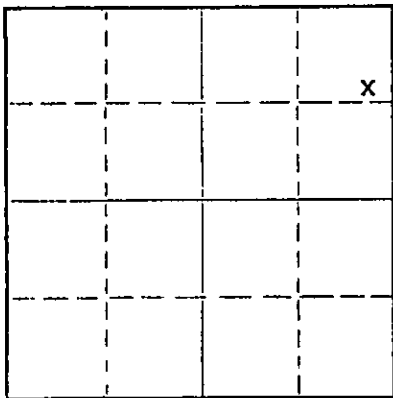

Locate well correctly on above Section Plat

Saline County. Sec. 28 Twp. 15 Rge. 3 1/4 (W) (KCC)
Location as "NE/CNW/SW" or footage from lines NE NE SE NW/2/4SE
Lease Owner Mutual Oil Company, Inc.
Lease Name Hedquist Well No. 1
Office Address Planters Bank Arcadd, Salina, Kansas
Character of Well (completed as Oil, Gas or Dry Hole) XXX Dry hole
Date well completed 4-03 19 63
Application for plugging filed 4-05 19 63
Application for plugging approved 4-05 19 63
Plugging commenced 4-06 19 63
Plugging completed 19
Reason for abandonment of well or producing formation dry hole

If a producing well is abandoned, date of last production 19
Was permission obtained from the Conservation Division or its agents before plugging was commenced? yes

Name of Conservation Agent who supervised plugging of this well Gilbert J. Toman
Producing formation Depth to top Bottom Total Depth of Well 3375 Feet
Show depth and thickness of all water, oil and gas formations.

OIL, GAS OR WATER RECORDS

CASING RECORD

FORMATION	CONTENT	FROM	TO	SIZE	PUT IN	PULLED OUT
				5 1/2		2778.86

Describe in detail the manner in which the well was plugged, indicating where the mud fluid was placed and the method or methods used in introducing it into the hole. If cement or other plugs were used, state the character of same and depth placed, from feet to feet for each plug set.

Set rock bridge from 3200 to 3195 feet on top of packer that was left in hole. Dumped 5 sacks of cement.
Set rock bridge from 200 to 190 feet and dumped 20 sacks cement.
Mud hole to 40 feet, set 10 foot rock bridge from 40 to 30 feet and dumped 10 sacks of cement.

RECEIVED
STATE CORPORATION COMMISSION

APR 23 1963
04-23-1963

CONSERVATION DIVISION
Wichita, Kansas

(If additional description is necessary, use BACK of this sheet)
Name of Plugging Contractor Kent Well Servicing Company
Address Box 470, El Dorado, Kansas

STATE OF Kansas, COUNTY OF Butler, ss.
(employee of owner) or (owner or operator) of the above-described well, being first duly sworn on oath, says: That I have knowledge of the facts, statements, and matters herein contained and the log of the above-described well as filed and that the same are true and correct. So help me God.

(Signature) *[Signature]*
(Address)

SUBSCRIBED AND SWORN TO before me this 22nd day of April, 1963

My commission expires 12-20-1963 *[Signature]* Notary Public.