



KANSAS CORPORATION COMMISSION 1066257
OIL & GAS CONSERVATION DIVISION

Form ACO-1
June 2009
Form Must Be Typed
Form must be Signed
All blanks must be Filled

CONFIDENTIAL

WELL COMPLETION FORM
WELL HISTORY - DESCRIPTION OF WELL & LEASE

OPERATOR: License # 34192
Name: SandRidge Exploration and Production LLC
Address 1: 123 ROBERT S. KERR AVE
Address 2: _____
City: OKLAHOMA CITY State: OK Zip: 73102 + 6406
Contact Person: Gil Messersmith
Phone: (405) 429-5500
CONTRACTOR: License # 34464
Name: Lariat Services, Inc.
Wellsite Geologist: Kathy Gentry
Purchaser: NCRA

Designate Type of Completion:

- New Well Re-Entry Workover
- Oil WSW SWD SIOW
 Gas D&A ENHR SIGW
 OG GSW Temp. Abd.
 CM (Coal Bed Methane)
 Cathodic Other (Core, Expl., etc.): _____

If Workover/Re-entry: Old Well Info as follows:

Operator: _____
Well Name: _____
Original Comp. Date: _____ Original Total Depth: _____
 Deepening Re-perf. Conv. to ENHR Conv. to SWD
 Conv. to GSW
 Plug Back: _____ Plug Back Total Depth
 Commingled Permit #: _____
 Dual Completion Permit #: _____
 SWD Permit #: _____
 ENHR Permit #: _____
 GSW Permit #: _____

<u>10/10/2011</u>	<u>10/25/2011</u>	<u>12/03/2011</u>
Spud Date or Recompletion Date	Date Reached TD	Completion Date or Recompletion Date

API No. 15 - 15-033-21595-01-00
Spot Description: _____
S2 S2 SE SE Sec. 25 Twp. 31 S. R. 20 East West
250 Feet from North / South Line of Section
660 Feet from East / West Line of Section
Footages Calculated from Nearest Outside Section Corner:
 NE NW SE SW
County: Comanche
Lease Name: Mariah Well #: 1-36H
Field Name: PIPELINE NORTHWEST
Producing Formation: Mississippi
Elevation: Ground: 2071 Kelly Bushing: 2091
Total Depth: 9999 Plug Back Total Depth: _____
Amount of Surface Pipe Set and Cemented at: 834 Feet
Multiple Stage Cementing Collar Used? Yes No
If yes, show depth set: _____ Feet
If Alternate II completion, cement circulated from: _____
feet depth to: _____ w/ _____ sx cmt.

Drilling Fluid Management Plan

(Data must be collected from the Reserve Pit)

Chloride content: 9350 ppm Fluid volume: 2080 bbls
Dewatering method used: Hauled to Disposal
Location of fluid disposal if hauled offsite: _____
Operator Name: Native American water service's LLC
Lease Name: German #2 SWD License #: 34025
Quarter NE Sec. 28 Twp. 29 S. R. 22 East West
County: Harper Permit #: OCC 222660

AFFIDAVIT


I am the affiant and I hereby certify that all requirements of the statutes, rules and regulations promulgated to regulate the oil and gas industry have been fully complied with and the statements herein are complete and correct to the best of my knowledge.

Submitted Electronically

KCC Office Use ONLY

- Letter of Confidentiality Received
Date: 01/23/2012
 Confidential Release Date: _____
 Wireline Log Received
 Geologist Report Received
 UIC Distribution
ALT I II III Approved by: NAOMI JAMES Date: 01/24/2012

TOPOGRAPHIC LAND SURVEYORS
 6709 NORTH CLASSEN BLVD., OKLA. CITY, OKLA. 73116 • LOCAL (405) 843-4847 • OUT OF STATE (800) 651-3219
 Certificate of Authorization No. LS-99, Exp. Dec 31, 2011
 GOMANCHE County, Kansas

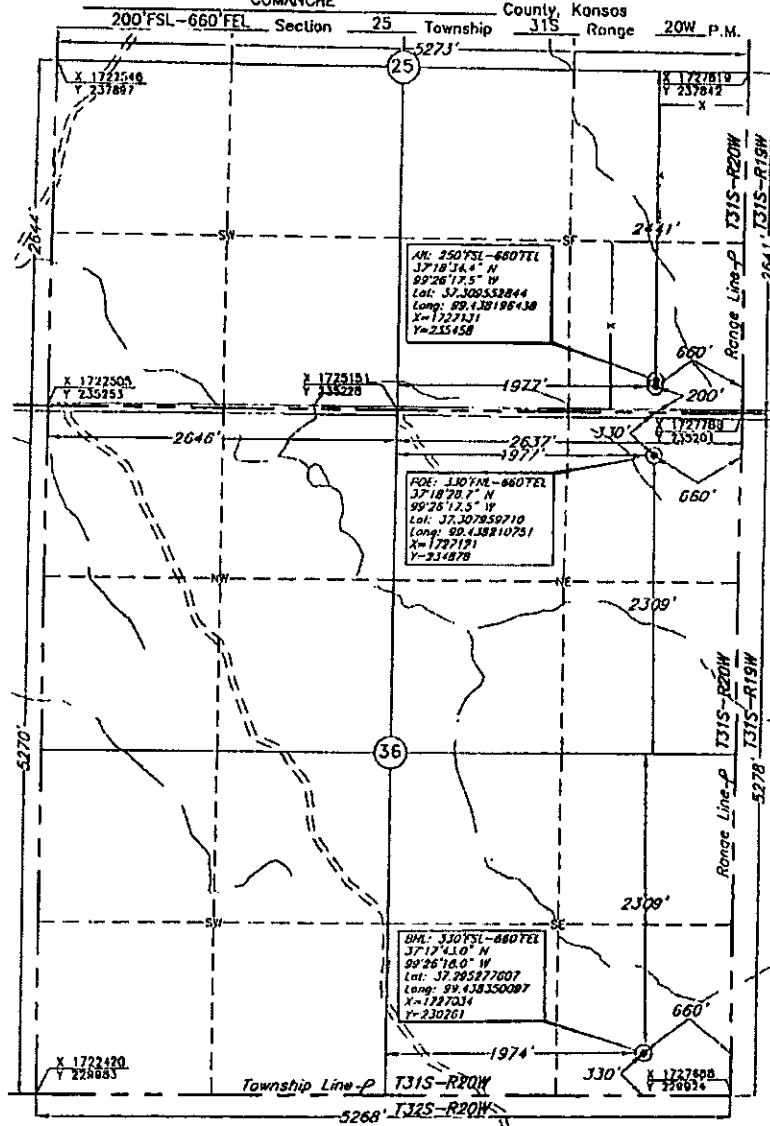

EIGHTH AND SEQUENTIUM PROPOSED
 BY OPERATOR LISTED
 CORNER COORDINATES ARE TAKEN
 FROM POINTS SURVEYED IN THE FIELD.



This location has been very carefully staked on the ground according to the best official survey records, maps, and photographs available to us, but its accuracy is not guaranteed. Review this plot and notify us immediately of any possible discrepancy.

Distances shown in (parenthesis) are calculated based upon the Quarter Section being 2640 feet, and have not been measured.

Operator: SANDRIDGE ENERGY, INC. ELEVATION: 2069' Gr. at Stake
 Lease Name: MARIAH Well No.: 1-30H

Topography & Vegetation Loc. fell in sloped alfalfa field, 117' North of E-W pipeline
Alt: fell in sloped alfalfa field

Good Drill Site? No Alt: Yes Reference Stakes or Alternate Location Stakes Set 250' FSL-660' FEL Elev: 2069' at Gr.


Best Accessibility to Location From South
 Distance & Direction From Hwy Jct or Town From the Jct. of US. Hwy. 183 & US. Hwy. 160 East, North of Coldwater, Ks., go 2 miles North on US. Hwy. 183, then 6 miles West to the SE Cor. of Sec. 25-T31S-R20W


The following information was gathered using a GPS receiver
 Accuracy 12-3 Meters.

GPS
 DATUM: NAD-27
 LAT: 37°18'33.9"N
 LONG: 99°26'17.5"W
 LAT: 37.309415501
 LONG: 99.438198146
 STATE PLANE
 COORDINATES:
 ZONE: KS SOUTH
 X: 1227130
 Y: 235408

Date of Drawing: Jun. 23, 2011
 Invoice # 169225 Data Staked: Jun. 17, 2011 LC

CERTIFICATE:
 I, T. Wayne Fisch a Registered Land Surveyor and an authorized agent of Topographic Land Surveyors, do hereby certify that the above described well location was surveyed and staked on the ground as shown herein.
 Kansas Reg. No. 1213

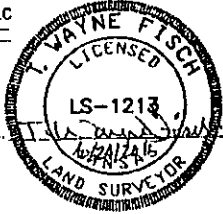

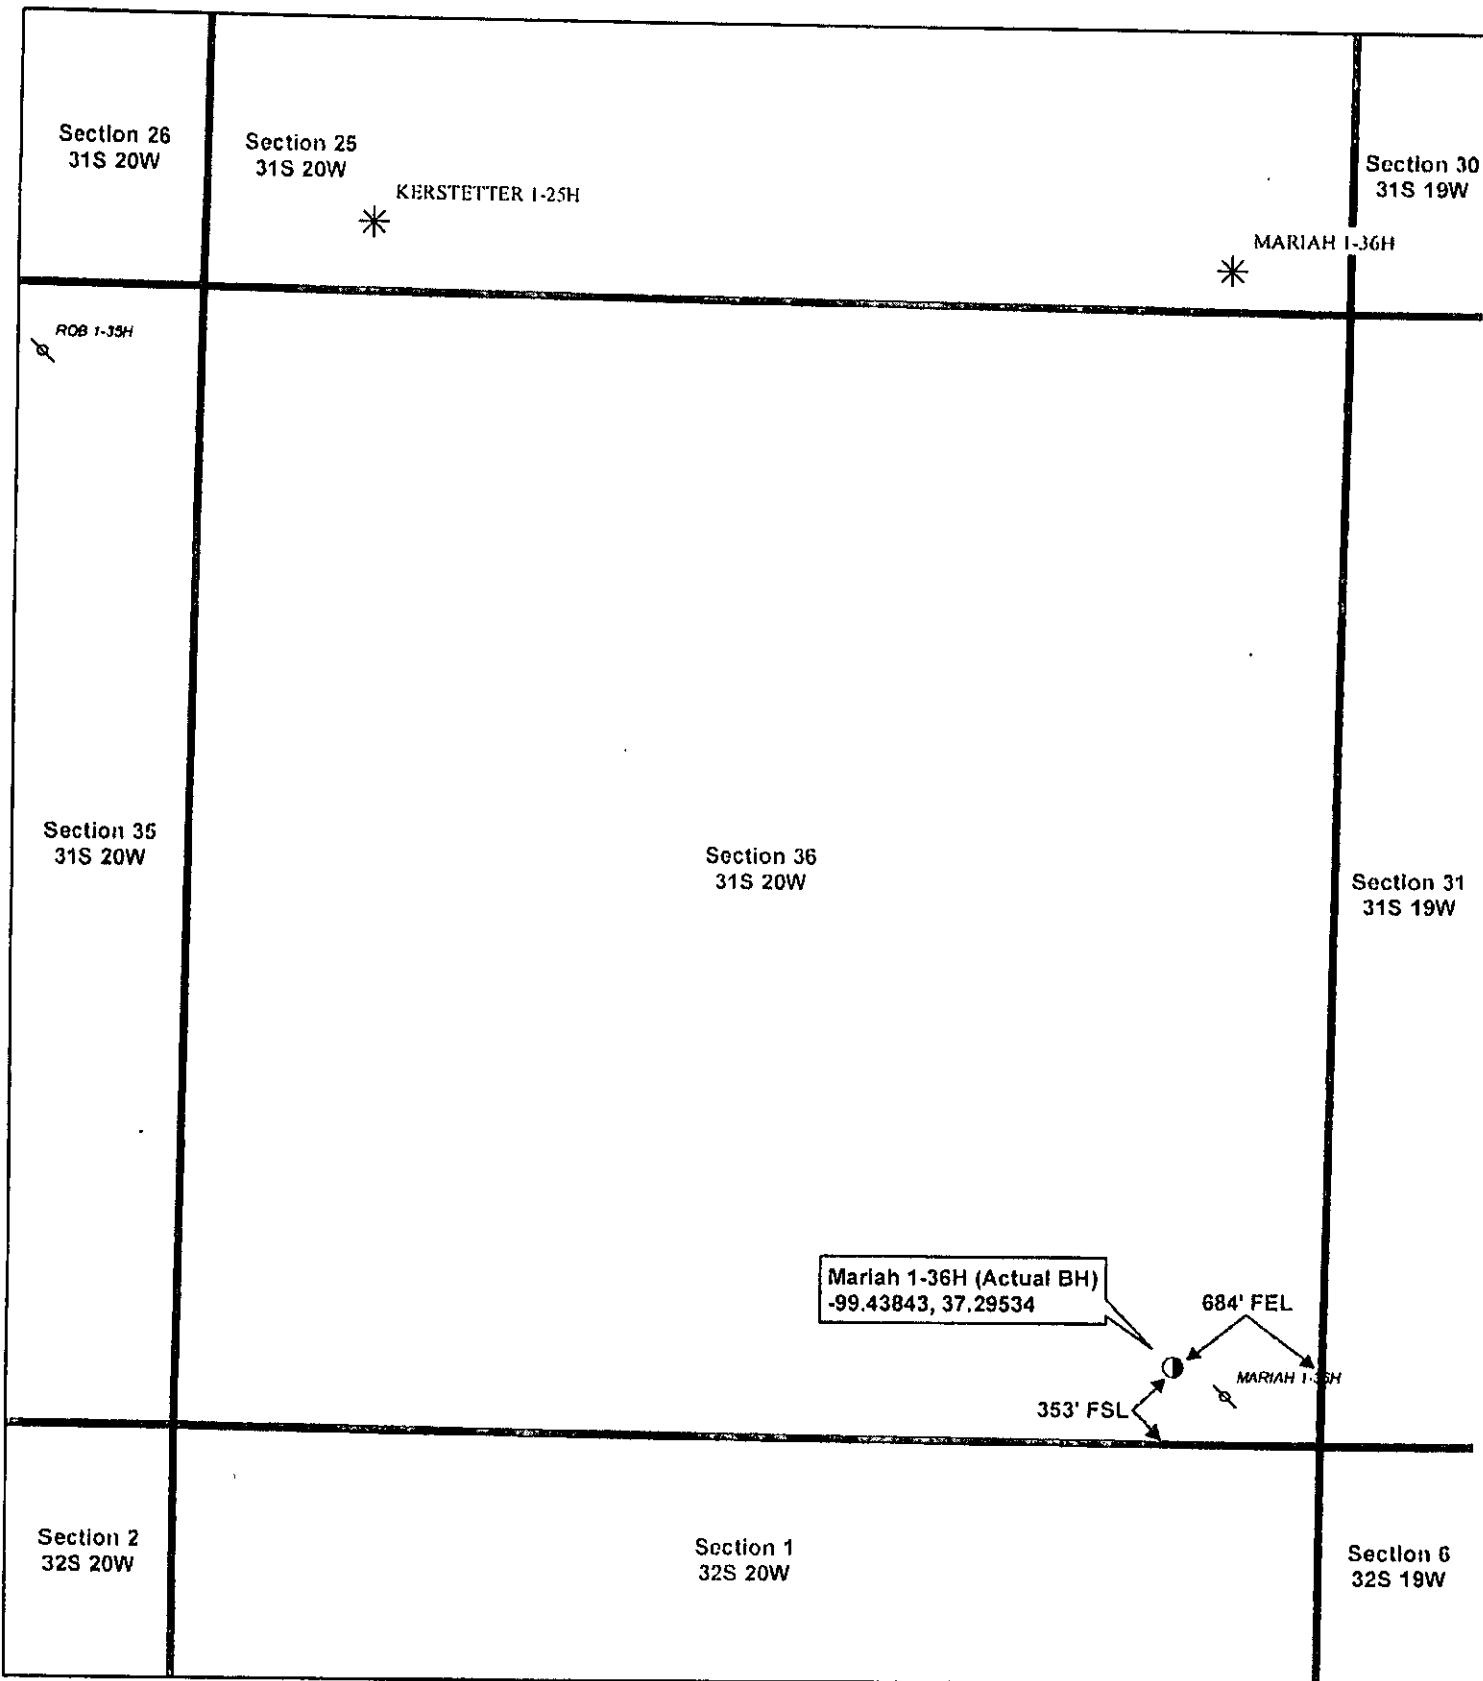

SANDRIDGE
THE POWER OF US™

Actual Bottom-Hole Location of Mariah 1-36H
Comanche County, Kansas
T&R: 31S 20W
Section: 36, 353' FSL & 684' FEL
Long: -99.43843, Lat: 37.29534

1 in = 833 ft

0 600 1,200 2,400 Feet

Draftsman:
Matt White

Draft Date: 1/23/2012

Drawing Name/Number:
Addendum_Mariah_1-36H.mxd

Coordinate System:
NAD 1927 State Plane
Kansas South FIPS: 1502

- Actual BH Location
- Projected BH
- SandRidge Wells
- PLSS Sections

DRILTECH MWD SURVEY REPORT

Company: Sandridge Energy
 Well: Mariah 1-36H
 Location: Sec 25- T31S- R20W
 Rig: Lariat 38

Job Number: KTX-021
 Magnetic Decl.: 6.15
 Grid Corr.: _____
 Total Grid Corr.: 6.15

Calculation Method Minimum Curvature
 Proposed Azimuth 181.07
 WELL API # _____
 Tie Into: MWD

Survey #	Survey Tool Type	Survey Depth (ft)	Inclination (deg)	Azimuth (deg)	Course Length (ft)	True Vertical Depth (ft)	Vertical Section (ft)	Coordinates		Closure		Dogleg Severity (d/100')	Build Rate (d/100')		
								N/S (ft)	E/W (ft)	Distance (ft)	Angle (deg)				
Tie In	Mwd	0	0.00	0.00	0	0	0	0	0	0	0	0	0		
1	Mwd	859.00	0.60	249.60	859	858.98	1.65	1.57	S	4.22	W	4.50	249.60	0.07	0.07
2	Mwd	1133.00	1.00	267.90	274	1132.96	2.30	2.16	S	7.95	W	8.24	254.83	0.17	0.15
3	Mwd	1610.00	0.80	1.60	477	1609.92	-0.80	1.02	N	12.02	W	12.06	274.86	0.28	-0.04
4	Mwd	2086.00	0.80	343.70	476	2085.87	-7.29	7.53	N	12.86	W	14.90	300.36	0.05	0.00
5	Mwd	2562.00	0.80	0.30	476	2561.83	-13.78	14.04	N	13.77	W	19.67	315.56	0.05	0.00
6	Mwd	3038.00	0.50	269.70	476	3037.80	-17.06	17.36	N	15.83	W	23.49	317.63	0.20	-0.06
7	Mwd	3514.00	0.80	313.10	476	3513.78	-19.23	19.62	N	20.33	W	28.25	313.97	0.12	0.06
8	Mwd	3989.00	1.00	345.30	475	3988.72	-25.44	25.89	N	23.81	W	35.17	317.40	0.11	0.04
9	Mwd	4021.00	1.00	351.70	32	4020.72	-25.99	26.44	N	23.92	W	35.65	317.86	0.35	0.00
10	Mwd	4053.00	0.80	357.70	32	4052.71	-26.48	26.94	N	23.97	W	36.06	318.34	0.69	-0.63
11	Mwd	4085.00	1.00	351.80	32	4084.71	-26.98	27.44	N	24.02	W	36.46	318.80	0.69	0.63
12	Mwd	4116.00	1.00	351.70	31	4115.70	-27.52	27.97	N	24.09	W	36.92	319.26	0.01	0.00
13	Mwd	4148.00	1.00	354.40	32	4147.70	-28.07	28.53	N	24.16	W	37.38	319.74	0.15	0.00
14	Mwd	4180.00	1.00	1.90	32	4179.69	-28.63	29.08	N	24.18	W	37.82	320.26	0.41	0.00
15	Mwd	4212.00	1.20	11.40	32	4211.69	-29.24	29.69	N	24.10	W	38.24	320.93	0.84	0.63
16	Mwd	4275.00	0.90	20.90	63	4274.68	-30.35	30.80	N	23.80	W	38.92	322.31	0.55	-0.48
17	Mwd	4307.00	1.00	210.10	32	4306.68	-30.34	30.79	N	23.85	W	38.95	322.24	5.92	0.31
18	Mwd	4338.00	3.80	205.50	31	4337.64	-29.17	29.63	N	24.43	W	38.40	320.50	9.05	9.03
19	Mwd	4370.00	5.60	199.20	32	4369.54	-26.72	27.20	N	25.40	W	37.21	316.96	5.84	5.63
20	Mwd	4402.00	7.40	193.90	32	4401.33	-23.23	23.72	N	26.40	W	35.50	311.94	5.92	5.63
21	Mwd	4433.00	9.40	193.30	31	4432.00	-18.81	19.32	N	27.47	W	33.58	305.13	6.46	6.45
22	Mwd	4465.00	12.00	195.70	32	4463.44	-13.03	13.58	N	28.97	W	31.99	295.11	8.24	8.13
23	Mwd	4497.00	14.60	197.80	32	4494.58	-5.95	6.53	N	31.10	W	31.78	281.86	8.26	8.13
24	Mwd	4529.00	16.70	197.20	32	4525.39	2.33	1.70	S	33.69	W	33.74	267.11	6.58	6.56
25	Mwd	4560.00	19.70	195.70	31	4554.83	11.67	10.99	S	36.43	W	38.05	253.21	9.79	9.68
26	Mwd	4592.00	22.50	194.60	32	4584.69	22.84	22.11	S	39.43	W	45.20	240.72	8.84	8.75
27	Mwd	4624.00	24.50	194.90	32	4614.03	35.24	34.45	S	42.68	W	54.85	231.09	6.26	6.25
28	Mwd	4656.00	26.50	193.20	32	4642.91	48.66	47.81	S	46.02	W	66.36	223.90	6.65	6.25
29	Mwd	4687.00	28.90	189.30	31	4670.36	62.84	61.94	S	48.81	W	78.86	218.24	9.70	7.74
30	Mwd	4719.00	31.00	187.80	32	4698.08	78.68	77.74	S	51.17	W	93.07	213.36	6.97	6.56
31	Mwd	4751.00	33.00	186.20	32	4725.22	95.54	94.57	S	53.23	W	108.52	209.38	6.79	6.25
32	Mwd	4783.00	36.10	183.80	32	4751.58	113.64	112.64	S	54.80	W	125.26	205.94	10.58	9.69

DRILTECH MWD SURVEY REPORT

Company:	Sandridge Energy	Job Number:	KTX-021
Well:	Mariah 1-36H	Magnetic Decl.:	6.15
Location:	Sec 25- T31S- R20W	Grid Corr.:	
Rig:	Lariat 38	Total Grid Corr.:	6.15
		Calculation Method	Minimum Curvature
		Proposed Azimuth	181.07
		WELL API #	
		Tie Into:	MWD

Survey #	Survey Tool Type	Survey Depth (ft)	Inclination (deg)	Azimuth (deg)	Course Length (ft)	True Vertical Depth (ft)	Vertical Section (ft)	Coordinates		Closure		Dogleg Severity (d/100')	Build Rate (d/100')		
								N/S (ft)	E/W (ft)	Distance (ft)	Angle (deg)				
33	Mwd	4814.00	38.20	182.90	31	4776.28	132.35	131.33	S	55.89	W	142.73	203.05	7.00	6.77
34	Mwd	4846.00	39.70	183.00	32	4801.17	152.45	151.42	S	56.93	W	161.77	200.60	4.69	4.69
35	Mwd	4878.00	41.00	182.60	32	4825.56	173.16	172.11	S	57.94	W	181.60	198.60	4.14	4.06
36	Mwd	4910.00	42.90	182.10	32	4849.35	194.55	193.48	S	58.81	W	202.23	196.91	6.03	5.94
37	Mwd	4942.00	44.90	181.00	32	4872.41	216.73	215.66	S	59.41	W	223.70	195.40	6.69	6.25
38	Mwd	4973.00	47.10	180.40	31	4893.94	239.03	237.96	S	59.68	W	245.33	194.08	7.23	7.10
39	Mwd	5005.00	47.70	179.60	32	4915.60	262.58	261.51	S	59.68	W	268.24	192.86	2.63	1.88
40	Mwd	5037.00	50.00	180.10	32	4936.66	286.67	285.61	S	59.62	W	291.76	191.79	7.28	7.19
41	Mwd	5069.00	50.40	180.20	32	4957.14	311.25	310.19	S	59.68	W	315.88	190.89	1.27	1.25
42	Mwd	5100.00	50.20	179.80	31	4976.94	335.10	334.04	S	59.68	W	339.33	190.13	1.18	-0.65
43	Mwd	5132.00	50.00	179.60	32	4997.47	359.64	358.59	S	59.55	W	363.50	189.43	0.79	-0.63
44	Mwd	5164.00	49.90	179.30	32	5018.06	384.13	383.09	S	59.32	W	387.65	188.80	0.78	-0.31
45	Mwd	5195.00	49.50	178.90	31	5038.11	407.76	406.73	S	58.95	W	410.98	188.25	1.62	-1.29
46	Mwd	5227.00	49.60	178.50	32	5058.87	432.09	431.07	S	58.40	W	435.01	187.71	1.00	0.31
47	Mwd	5259.00	52.10	178.70	32	5079.07	456.88	455.88	S	57.79	W	459.53	187.22	7.83	7.81
48	Mwd	5291.00	55.20	180.10	32	5098.04	482.64	481.65	S	57.53	W	485.07	186.81	10.31	9.69
49	Mwd	5322.00	58.50	181.10	31	5114.99	508.59	507.59	S	57.80	W	510.87	186.50	10.98	10.65
50	Mwd	5354.00	61.60	181.80	32	5130.96	536.31	535.31	S	58.51	W	538.50	186.24	9.87	9.69
51	Mwd	5386.00	65.50	181.40	32	5145.21	564.95	563.94	S	59.30	W	567.05	186.00	12.24	12.19
52	Mwd	5418.00	69.40	181.10	32	5157.48	594.50	593.48	S	59.95	W	596.50	185.77	12.22	12.19
53	Mwd	5449.00	73.40	181.10	31	5167.37	623.87	622.85	S	60.51	W	625.78	185.55	12.90	12.90
54	Mwd	5481.00	76.40	181.00	32	5175.70	654.77	653.74	S	61.08	W	656.59	185.34	9.38	9.38
55	Mwd	5513.00	78.90	180.50	32	5182.55	686.02	684.99	S	61.49	W	687.75	185.13	7.96	7.81
56	Mwd	5544.00	81.70	180.20	31	5187.77	716.57	715.55	S	61.67	W	718.20	184.93	9.08	9.03
57	Mwd	5638.00	85.10	180.60	94	5198.57	809.93	808.91	S	62.33	W	811.30	184.41	3.64	3.62
58	Mwd	5670.00	84.80	179.90	32	5201.39	841.80	840.78	S	62.46	W	843.10	184.25	2.37	-0.94
59	Mwd	5702.00	86.20	178.10	32	5203.90	873.68	872.68	S	61.91	W	874.87	184.06	7.11	4.38
60	Mwd	5734.00	88.80	177.30	32	5205.30	905.59	904.62	S	60.62	W	906.65	183.83	8.50	8.12
61	Mwd	5766.00	89.60	176.60	32	5205.74	937.51	936.57	S	58.92	W	938.42	183.60	3.32	2.50
62	Mwd	5798.00	89.30	176.40	32	5206.05	969.40	968.51	S	56.97	W	970.18	183.37	1.13	-0.94
63	Mwd	5830.00	91.20	176.30	32	5205.91	1001.29	1000.44	S	54.93	W	1001.95	183.14	5.95	5.94
64	Mwd	5861.00	91.70	176.60	31	5205.13	1032.18	1031.37	S	53.01	W	1032.73	182.94	1.88	1.61
65	Mwd	5893.00	92.00	176.10	32	5204.09	1064.06	1063.29	S	50.98	W	1064.51	182.74	1.82	0.94
66	Mwd	5925.00	91.90	176.80	32	5203.01	1095.93	1095.21	S	49.00	W	1096.30	182.56	2.21	-0.31
67	Mwd	6021.00	91.40	177.40	96	5200.24	1191.66	1191.05	S	44.14	W	1191.86	182.12	0.81	-0.52
68	Mwd	6116.00	91.10	179.10	95	5198.17	1286.52	1285.98	S	41.24	W	1286.64	181.84	1.82	-0.32

DRILTECH MWD SURVEY REPORT

Company:	Sandridge Energy	Job Number:	KTX-021
Well:	Mariah 1-36H	Magnetic Decl.:	6.15
Location:	Sec 25- T31S- R20W	Grid Corr.:	
Rig:	Larriet 38	Total Grid Corr.:	6.15
		Calculation Method	Minimum Curvature
		Proposed Azimuth	181.07
		WELL API #	
		Tie Into:	MWD

Survey #	Survey Tool Type	Survey Depth (ft)	Inclination (deg)	Azimuth (deg)	Course Length (ft)	True Vertical Depth (ft)	Vertical Section (ft)	Coordinates		Closure		Dogleg Severity (d/100')	Build Rate (d/100')
								N/S (ft)	E/W (ft)	Distance (ft)	Angle (deg)		
69	Mwd	6212.00	91.20	178.90	96	5196.24	1382.44	1381.94 S	39.57 W	1382.51	181.64	0.23	0.10
70	Mwd	6308.00	90.60	180.20	96	5194.73	1478.39	1477.92 S	38.81 W	1478.43	181.50	1.49	-0.63
71	Mwd	6403.00	91.00	180.10	95	5193.41	1573.37	1572.91 S	39.06 W	1573.40	181.42	0.43	0.42
72	Mwd	6499.00	90.70	180.10	96	5191.98	1669.34	1668.90 S	39.23 W	1669.36	181.35	0.31	-0.31
73	Mwd	6595.00	90.80	180.90	96	5190.73	1765.33	1764.89 S	40.07 W	1765.35	181.30	0.84	0.10
74	Mwd	6691.00	88.30	181.00	96	5191.48	1861.32	1860.87 S	41.66 W	1861.33	181.28	2.61	-2.60
75	Mwd	6787.00	89.00	180.70	96	5193.74	1957.29	1956.83 S	43.08 W	1957.30	181.26	0.79	0.73
76	Mwd	6882.00	88.60	180.00	95	5195.73	2052.26	2051.81 S	43.66 W	2052.27	181.22	0.85	-0.42
77	Mwd	6978.00	88.60	179.60	96	5198.08	2148.21	2147.78 S	43.33 W	2148.21	181.16	0.42	0.00
78	Mwd	7074.00	89.20	179.70	96	5199.92	2244.16	2243.76 S	42.74 W	2244.16	181.09	0.63	0.63
79	Mwd	7169.00	90.40	179.80	95	5200.25	2339.14	2338.75 S	42.33 W	2339.14	181.04	1.27	1.26
80	Mwd	7265.00	90.90	179.80	96	5199.16	2435.11	2434.75 S	41.99 W	2435.11	180.99	0.52	0.52
81	Mwd	7360.00	90.20	180.90	95	5198.25	2530.09	2529.74 S	42.57 W	2530.10	180.96	1.37	-0.74
82	Mwd	7456.00	90.00	180.40	96	5198.08	2626.09	2625.73 S	43.66 W	2626.09	180.95	0.56	-0.21
83	Mwd	7552.00	90.00	180.10	96	5198.08	2722.08	2721.73 S	44.08 W	2722.09	180.93	0.31	0.00
84	Mwd	7647.00	90.60	179.80	95	5197.59	2817.06	2816.73 S	44.00 W	2817.07	180.89	0.71	0.63
85	Mwd	7743.00	90.10	180.40	96	5197.00	2913.04	2912.73 S	44.16 W	2913.06	180.87	0.81	-0.52
86	Mwd	7839.00	89.60	179.10	96	5197.25	3009.01	3008.72 S	43.74 W	3009.04	180.83	1.45	-0.52
87	Mwd	7934.00	89.40	177.50	95	5198.08	3103.90	3103.67 S	40.93 W	3103.94	180.76	1.70	-0.21
88	Mwd	8030.00	90.30	179.30	96	5198.33	3199.79	3199.63 S	38.25 W	3199.86	180.68	2.10	0.94
89	Mwd	8125.00	90.90	179.40	95	5197.34	3294.74	3294.62 S	37.17 W	3294.83	180.65	0.64	0.63
90	Mwd	8221.00	90.10	180.40	96	5196.50	3390.71	3390.61 S	37.00 W	3390.81	180.63	1.33	-0.83
91	Mwd	8339.00	86.60	181.20	118	5199.90	3508.64	3508.53 S	38.65 W	3508.75	180.63	3.04	-2.97
92	Mwd	8435.00	86.00	180.70	96	5206.09	3604.44	3604.32 S	40.24 W	3604.54	180.64	0.81	-0.62
93	Mwd	8530.00	85.90	180.60	95	5212.80	3699.20	3699.08 S	41.31 W	3699.31	180.64	0.15	-0.11
94	Mwd	8626.00	87.30	181.70	96	5218.49	3795.03	3794.88 S	43.23 W	3795.13	180.65	1.85	1.46
95	Mwd	8722.00	89.20	182.60	96	5221.43	3890.96	3890.77 S	46.83 W	3891.05	180.69	2.19	1.98
96	Mwd	8817.00	88.10	181.80	95	5223.66	3985.92	3985.67 S	50.48 W	3985.99	180.73	1.43	-1.16
97	Mwd	8913.00	89.90	183.80	96	5225.34	4081.85	4081.53 S	55.17 W	4081.90	180.77	2.80	1.88
98	Mwd	9008.00	90.10	183.00	95	5225.34	4176.77	4176.36 S	60.80 W	4176.80	180.83	0.87	0.21
99	Mwd	9104.00	90.00	183.00	96	5225.26	4272.71	4272.23 S	65.83 W	4272.74	180.88	0.10	-0.10
100	Mwd	9200.00	90.00	182.60	96	5225.26	4368.67	4368.11 S	70.52 W	4368.68	180.92	0.42	0.00
101	Mwd	9295.00	89.30	182.80	95	5225.84	4463.63	4463.01 S	74.99 W	4463.64	180.96	0.77	-0.74
102	Mwd	9391.00	88.60	181.80	96	5227.59	4559.59	4558.91 S	78.84 W	4559.59	180.99	1.27	-0.73
103	Mwd	9487.00	88.80	182.60	96	5229.77	4655.54	4654.82 S	82.53 W	4655.55	181.02	0.86	0.21
104	Mwd	9582.00	89.40	183.20	95	5231.27	4750.48	4749.68 S	87.33 W	4750.48	181.05	0.89	0.63

