

CARD MUST BE TYPED

State of Kansas
NOTICE OF INTENTION TO DRILL

CARD MUST BE SIGNED

(see rules on reverse side)

Starting Date: 3/10/85

month day year

API Number 15- 169-20, 278-00-00

OPERATOR: License # 5188

Name Silver Creek Oil & Gas, Inc.

Address 1900 No. Amidon, Ste. 221

City/State/Zip Wichita, KS 67203

Contact Person Gregory B. Porterfield

Phone (316) 832-0603

CONTRACTOR: License # 5107

Name H-30 Drilling

City/State Wichita, KS

Well Drilled For: Well Class: Type Equipment:

- | | | | |
|---|-------------------------------|---|--|
| <input checked="" type="checkbox"/> Oil | <input type="checkbox"/> Swd | <input checked="" type="checkbox"/> Infield | <input checked="" type="checkbox"/> Mud Rotary |
| <input type="checkbox"/> Gas | <input type="checkbox"/> Inj | <input type="checkbox"/> Pool Ext. | <input type="checkbox"/> Air Rotary |
| <input type="checkbox"/> OWWO | <input type="checkbox"/> Expl | <input type="checkbox"/> Wildcat | <input type="checkbox"/> Cable |

If OWWO: old well info as follows:

Operator

Well Name

Comp Date Old Total Depth

Projected Total Depth 3600 feet

Projected Formation at TD 3450

Expected Producing Formations Maquoketa

SW SE SE... Sec... 29 Twp. 15. S, Rge. 3. East
(location) West

..... 330..... Ft North from Southeast Corner of Section

..... 990..... Ft West from Southeast Corner of Section

(Note: Locate well on Section Plat on reverse side)

Nearest lease or unit boundary line 330..... feet.

County Saline.....

Lease Name Brown..... Well# 1.....

Domestic well within 330 feet: yes no

Municipal well within one mile: yes no

Depth to Bottom of fresh water 100..... feet

Lowest usable water formation Wellington.....

Depth to Bottom of usable water 200..... feet

Surface pipe by Alternate: 1 2

Surface pipe to be set 335+..... feet

Conductor pipe if any required 100 as needed..... feet

Ground surface elevation feet MSL.

This Authorization Expires 9-5-85

Approved By [Signature] 3-5-85

I certify that we will comply with K.S.A. 55-101, et seq., plus eventually plugging hole to K.C.C. specifications.

Date 2/18/85 Signature of Operator or Agent [Signature]


Title Secretary Form C-1 4/84

MHC/40HE 3-5-85

Must be filed with the K.C.C. five (5) days prior to commencing well
 This card void if drilling not started within six (6) months of date received by K.C.C.

Important procedures to follow :

**A Regular Section of Land
 1 Mile = 5,280 Ft.**

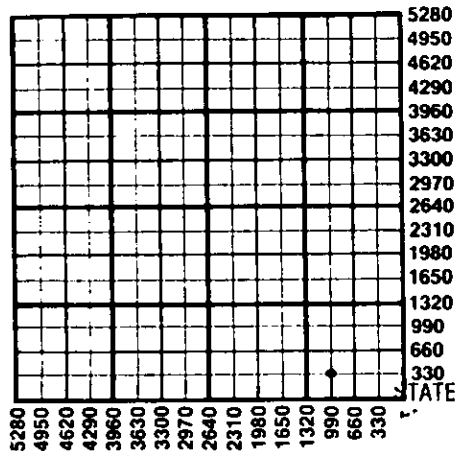

1. Notify District office before setting surface casing.
2. Set surface casing by circulating cement to the top.
3. File completion forms ACO-1 with K.C.C. within 90 days of well completion, following instructions on ACO-1, side 1, and including copies of wireline logs.
4. Notify District office 48 hours prior to old well workover or re-entry.
5. Prior to plugging, prepare a plugging plan, then obtain agreement from the appropriate district office for an approved plugging plan.
6. Submit plugging report (CP-4) to K.C.C. after plugging is completed.
7. Obtain an approved injection docket number before disposing of salt water.
8. Notify K.C.C. within 10 days when injection commences or terminates.

RECEIVED

STATE CORPORATION COMMISSION

On alternate 2 completion, cement in the production pipe from below
 any possible water to surface within 120 days of spud date.

MAR 5 1985
 03-05-1985
 CONSERVATION DIVISION
 Wichita, Kansas

State Corporation Commission of Kansas
 Conservation Division
 200 Colorado Derby Building
 Wichita, Kansas 67202
 (316) 263-3238