


STATE OF KANSAS
STATE CORPORATION COMMISSION

Form CP-4

WELL PLUGGING RECORD

Give All Information Completely
Make Required Affidavit
Mail or Deliver Report to:
Conservation Division
State Corporation Commission

P. O. Box 17027
Wichita, Kansas 67217
NORTH

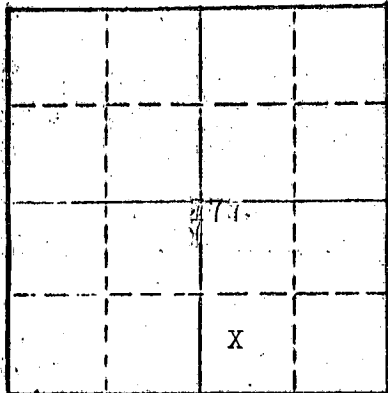

Locate well correctly on above
Section Plat

Saline County. Sec. 7 Twp. 14S Rge. 2 (E) (W)
Location as "NE/CNW/SW" or footage from lines 600' FWL-660' ESL SE/4
Lease Owner Sheldon Brothers Agency
Lease Name Sheldon Well No. 2
Office Address United Building Salina, Kansas 67401
Character of Well (completed as Oil, Gas or Dry Hole) Disposal
Date well completed 1973
Application for plugging filed Verbally November 2 1973
Application for plugging approved Verbally November 2 1973
Plugging commenced November 12 1973
Plugging completed November 12 1973
Reason for abandonment of well or producing formation Casing Collapsed

If a producing well is abandoned, date of last production 10
Was permission obtained from the Conservation Division or its agents before plugging was commenced? Yes

Name of Conservation Agent who supervised plugging of this well Gilbert Toman
Producing formation Maquoketa Depth to top 3193 Bottom 3198 Total Depth of Well 3198 Feet
Show depth and thickness of all water, oil and gas formations.

OIL, GAS OR WATER RECORDS

CASING RECORD

FORMATION	CONTENT	FROM	TO	SIZE	PUT IN	PULLED OUT
				8-5/8	225	None
				5-1/2	3,193	None

Describe in detail the manner in which the well was plugged, indicating where the mud fluid was placed and the method or methods used in introducing it into the hole. If cement or other plugs were used, state the character of same and depth placed, from feet to feet for each plug set.

Spotted 20 sx. of cement through tubing from 2,100 feet to 1,960 feet.
Pulled tubing up to 1500' and spotted 15 sx gel from 1,500 feet to 250 feet
Pulled tubing up to 250' and pumped in 75sx of cement from 250 feet to base of cellar of surface.
Hole in 5-1/2" permitted cement to go in 5-1/2" - 8 5/8" annulus. Filled to surface.

RECEIVED
STATE CORPORATION COMMISSION
NOV 21 1973
CONSERVATION DIVISION
Wichita, Kansas


(If additional description is necessary, use BACK of this sheet)
Name of Plugging Contractor Sheldon Brothers Agency
Address

STATE OF Kansas COUNTY OF Sedgwick
F. Doyle Fair (employer of owner) or (owner or operator) of the above-described well, being first duly sworn on oath, says: That I have knowledge of the facts, statements, and matters herein contained and the log of the above-described well as filed and that the same are true and correct. So help me God.

(Signature) F. Doyle Fair

F. Doyle Fair 800 Union Center Wichita, Kansas 67202
(Address)

Subscribed and sworn to before me this 20th day of November, 1973.

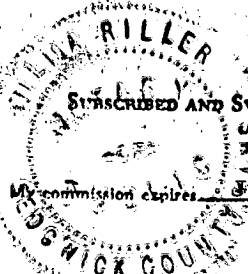

My commission expires July 27, 1975.

Wilma Riller, Notary Public.

15-169-19045-0000

F. DOYLE FAIR
PETROLEUM ENGINEER
800 UNION CENTER
WICHITA, KANSAS

November 20, 1973

RECEIVED
STATE CORPORATION COMMISSION
NOV 21 1973
CONSERVATION DIVISION
Wichita, Kansas

Mr. Frank Broadfoot
State Corporation Commission
P. O. Box 17027
Wichita, Kansas 67217

Dear Mr. Broadfoot:

Enclosed is a plugging record on the Sheldon #2 located in Section 7-14S-2W Saline County. I received a call that this disposal well stopped taking water. Initially we tried to clean out to the total depth of 3198. After encountering collapsed casing I called for you and you were out of the office. I explained to Mr. Brock our problem and he suggested I call Mr. Toman to be there the next time we tried to get past the collapsed casing.

On November 12 we tried again without success to get 2-3/8" tubing past the collapsed casing. Mr. Toman was there while this was taking place and supervised the entire plugging operation.

A driller's log is not available. A flood in 1951 apparently destroyed the records. The application for the disposal permit carried that notation.

Very truly yours,



F. Doyle Fair

FDF:gjt